


T.40S.,R.8W.,W.M.

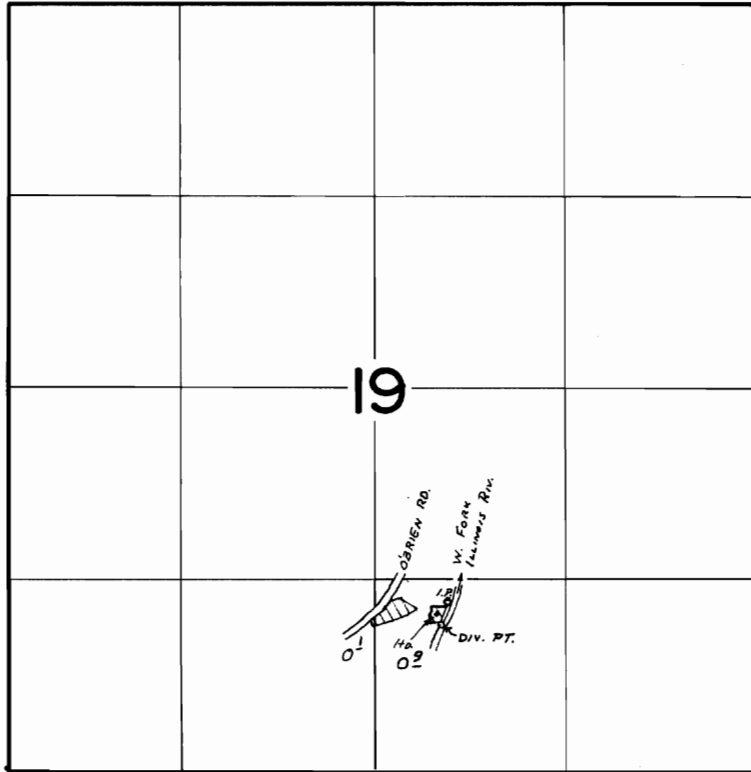

DIV. PT. - 1630' S AND 430' E FROM C¹/₄ COR. SEC. 19

FINAL PROOF SURVEY

UNDER

Transfer No. 0-57
2951

Application No. Permit No.
IN NAME OF

..... HARRY SONNIER

Surveyed Sept. 10. 1974, by L. Tolh