


T. 35 & 36 S., R. 1 W., W.M.

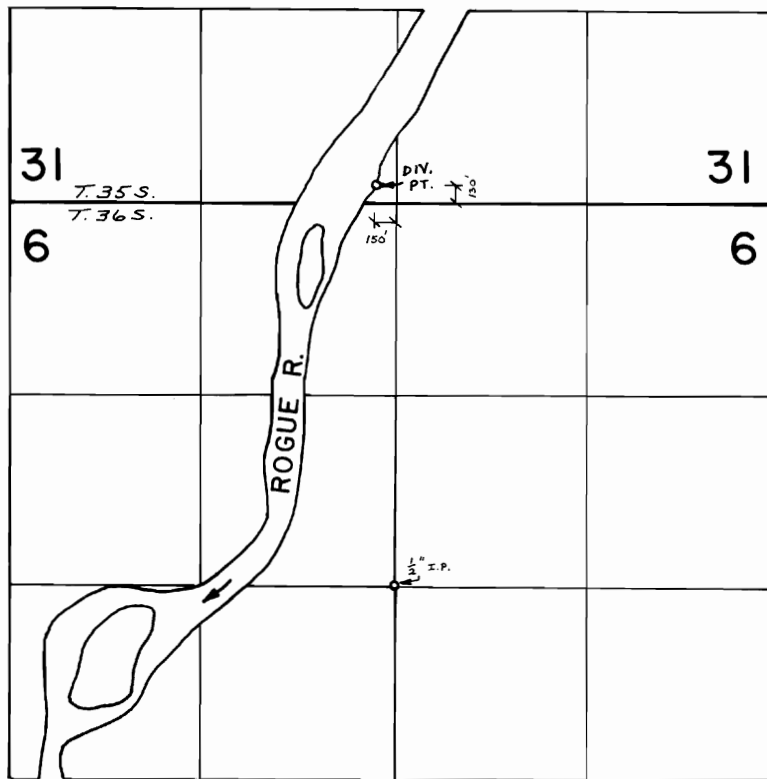

FINAL PROOF SURVEY UNDER

Application No. TR-2956 Permit No.
IN NAME OF

HERMAN HUEBNER

Surveyed AUG. 22 1978, by B. SUND