


T. 35 S., R. 4 W., W. M.

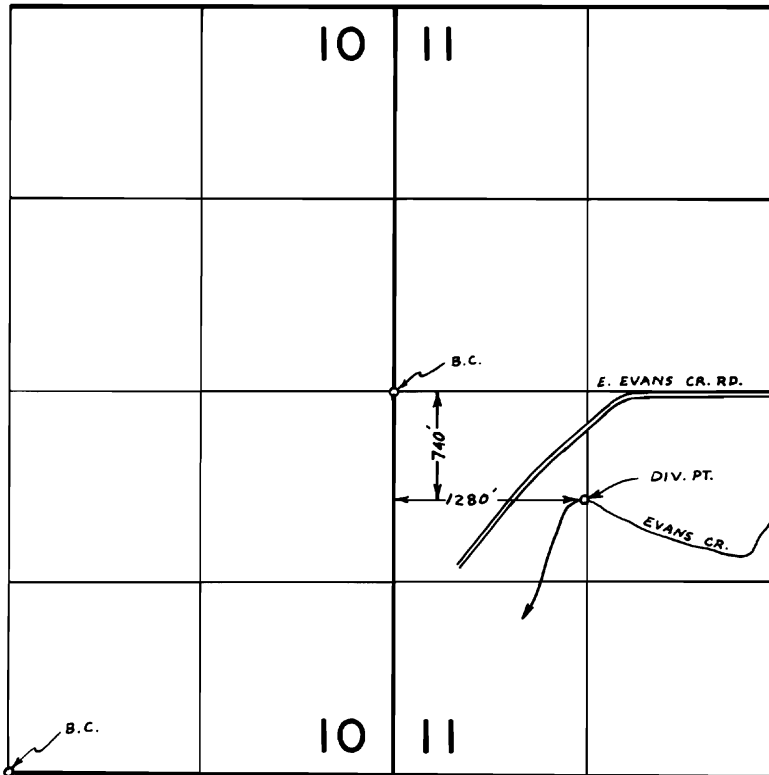

FINAL PROOF SURVEY
UNDER

Transfer No. 2968

Application No. Permit No.
IN NAME OF

RENE & MARY CHARLEBOIS

Surveyed MAY 16 78 by B. SUND
19.....