


T.14S., R.13E., W.M.

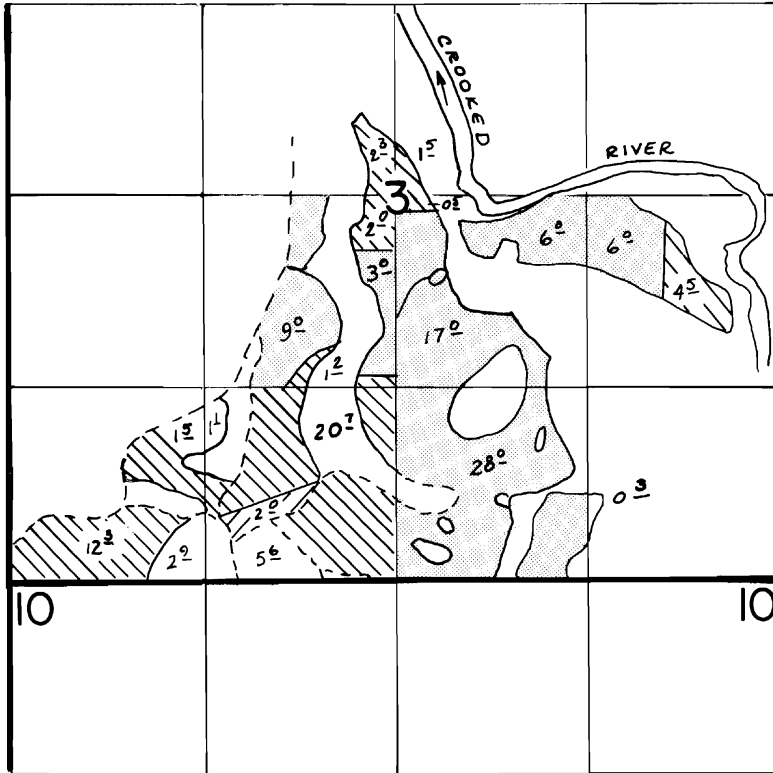

 CERT. 29052

SCALE: 1" = 1320'

FINAL PROOF SURVEY

UNDER



 Transfers 2969 & 4827

IN NAME OF

ART FOSS

Surveyed OCT. 15 1984, by L. OLSON