



T.2S. R.11E. W.M.

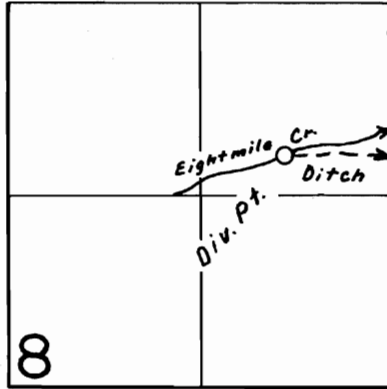

Copy

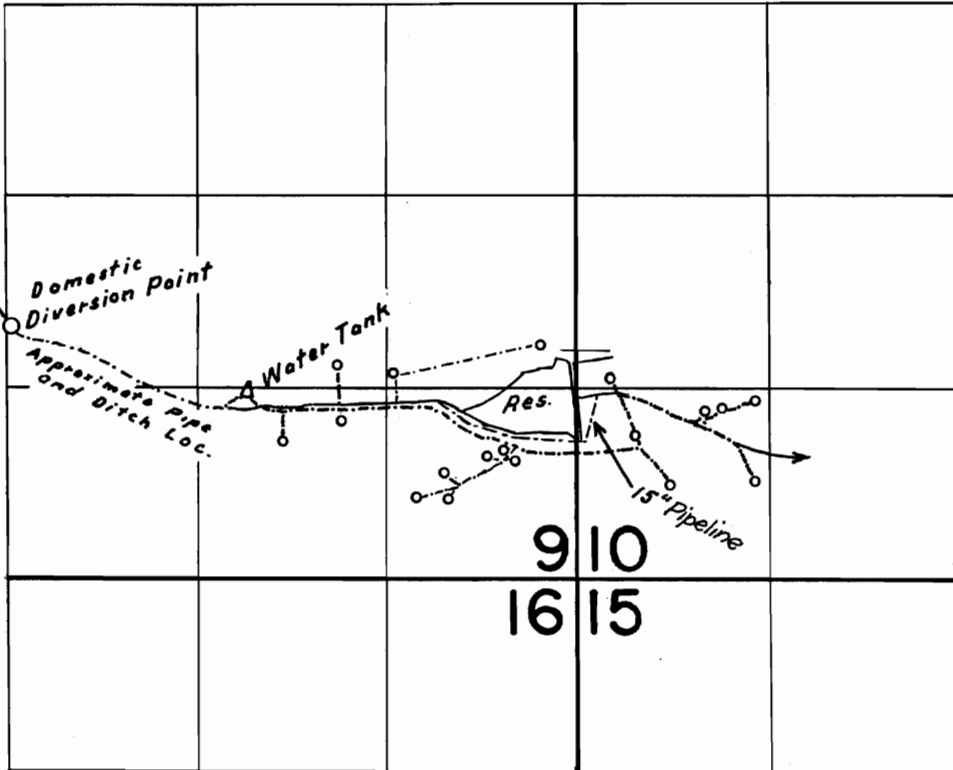

910
1615

o = Water Outlets

FINAL PROOF SURVEY
UNDER

R-37124 R-3200
Application No. 37125 Permit No. 28547
IN NAME OF

PORTLAND AREA COUNCIL, B. S. A.

Surveyed Oct. 20, 23, 24, 26, by *C. J. Gardner*
1964