


T.37 S.R.6 W.W.M.

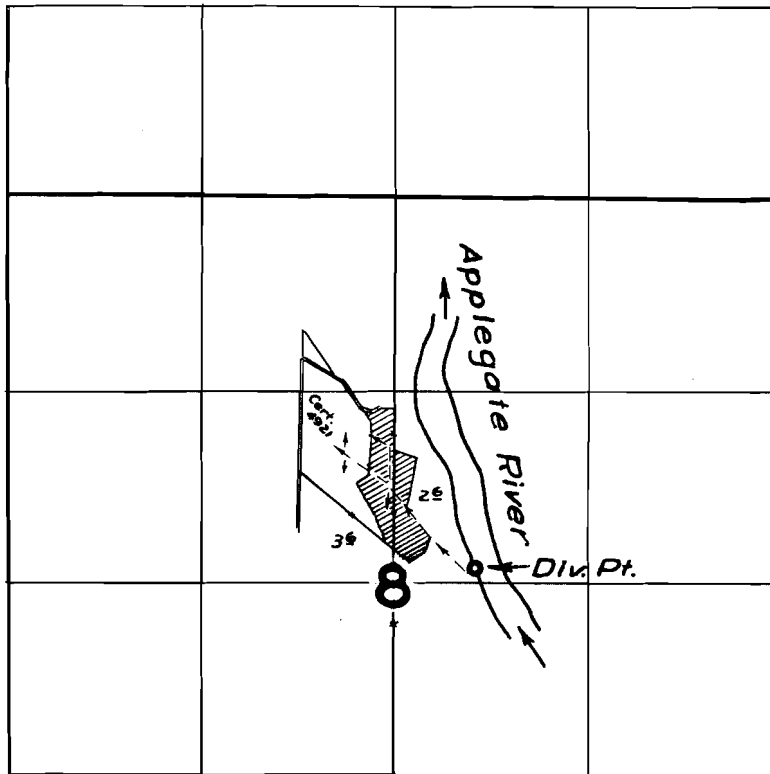

FINAL PROOF SURVEY
UNDER

Application No. 27400 Permit No. 21565
IN NAME OF

DALE H. ROGERS

Surveyed 23 July 1959, by M. B. Bish