


M-27-1973
V23, P45

JOHN LOUSIGNOUT D.L.C. 52

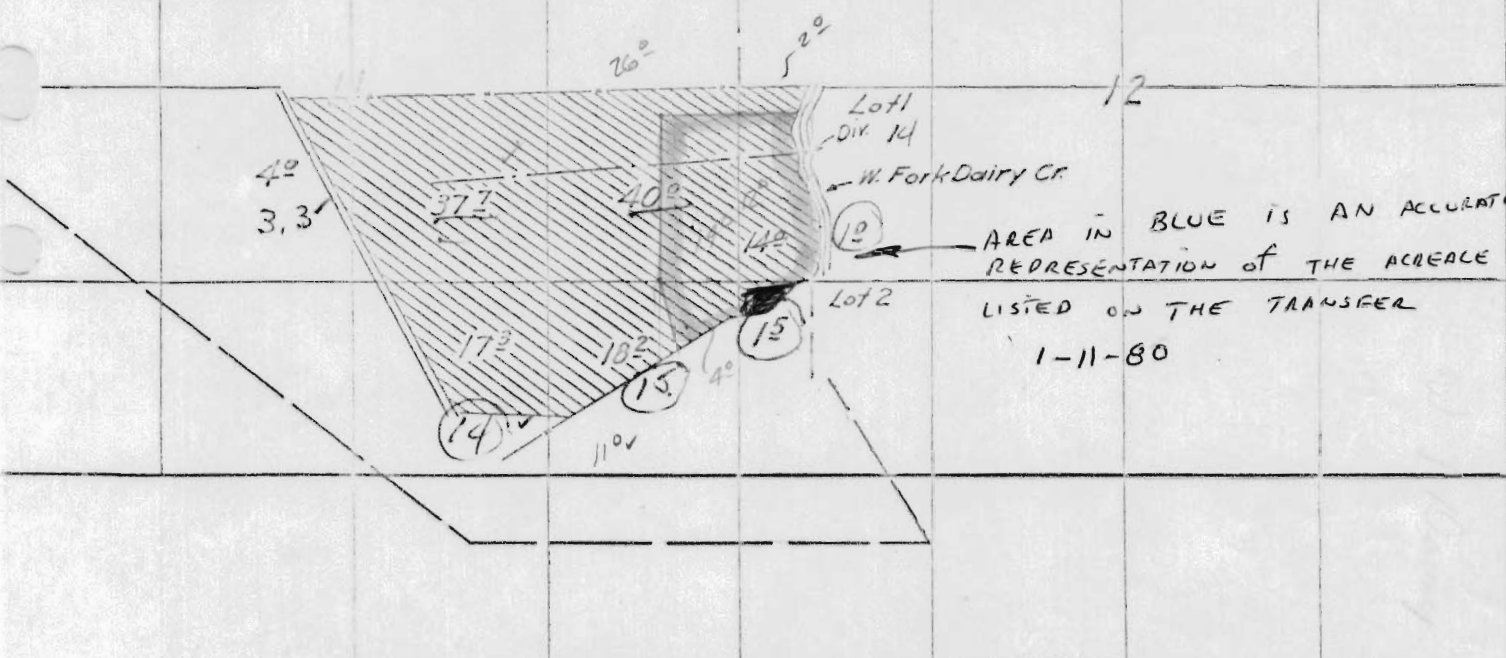

AREA IN BLUE IS AN ACCURATE REPRESENTATION OF THE ACREAGE LISTED ON THE TRANSFER 1-11-80

Surveyed Aug 15, 1941
Charles A. ...

L. J. ...

App. 17702

Per. 13308