


T.3S., R.4W., W.M.

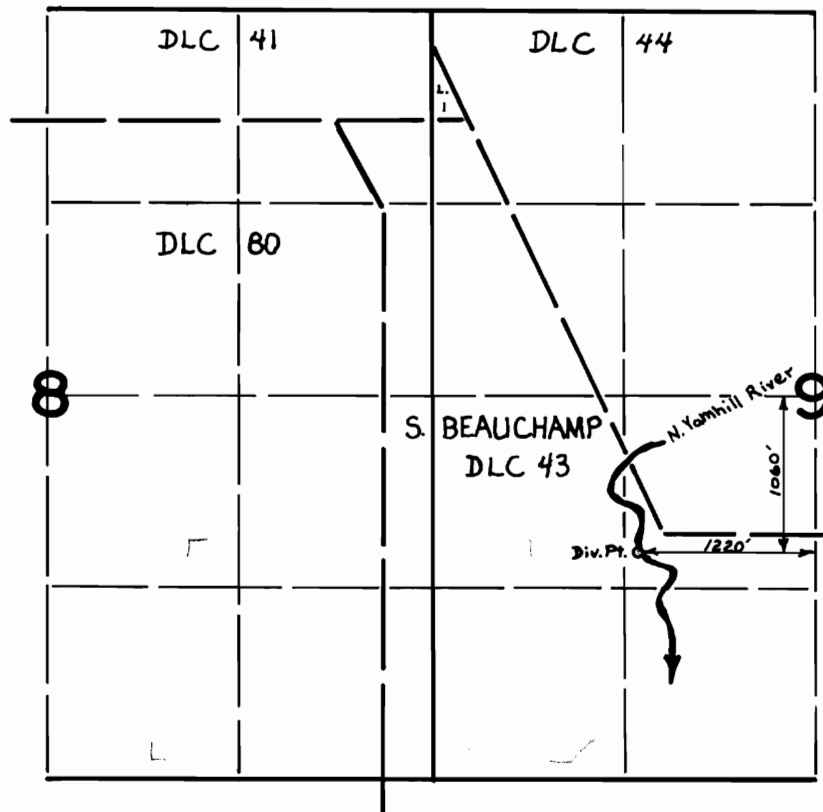

FINAL PROOF SURVEY
UNDER

Transfer No. 2992
IN NAME OF

THELMA JOHNSON

Surveyed JUNE 4 1976, by L. H. NUNN