


T.9 S. R.5 W. W.M.

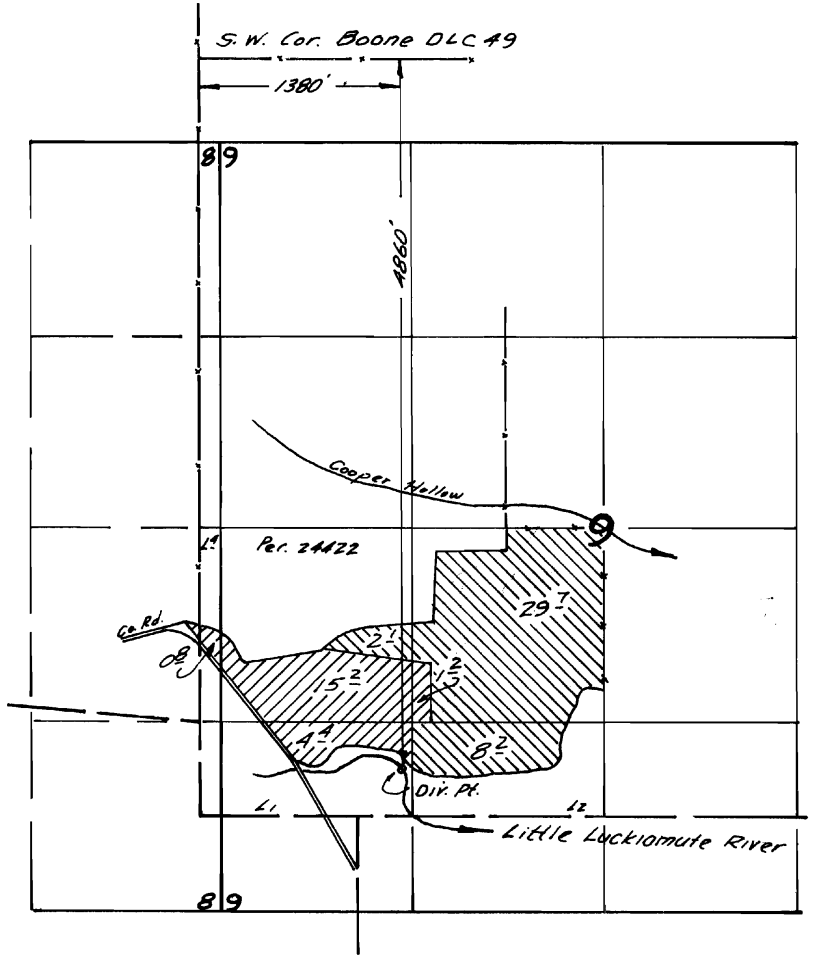

Application 51611



Transfer (new place of use) per. 18590

CLARE R. MILLHOUSER

Application No. 51611

Permit No.