


# T.16S. R.12E. W.M.

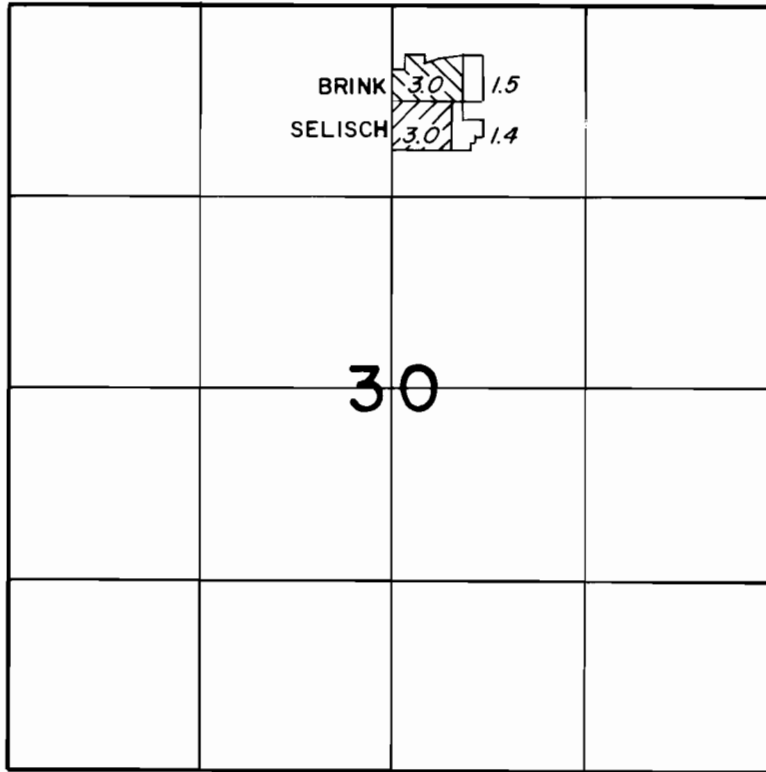

## FINAL PROOF SURVEY UNDER

TRANSFER 3007  
Application No. .... Permit No. ....  
IN NAME OF

.....ARNOLD BRINK & WALTER SELISCH.....

Surveyed MAY 25 1982, by L.H. NUNN.....