


T.5&6S., R.5&6W., W.M.

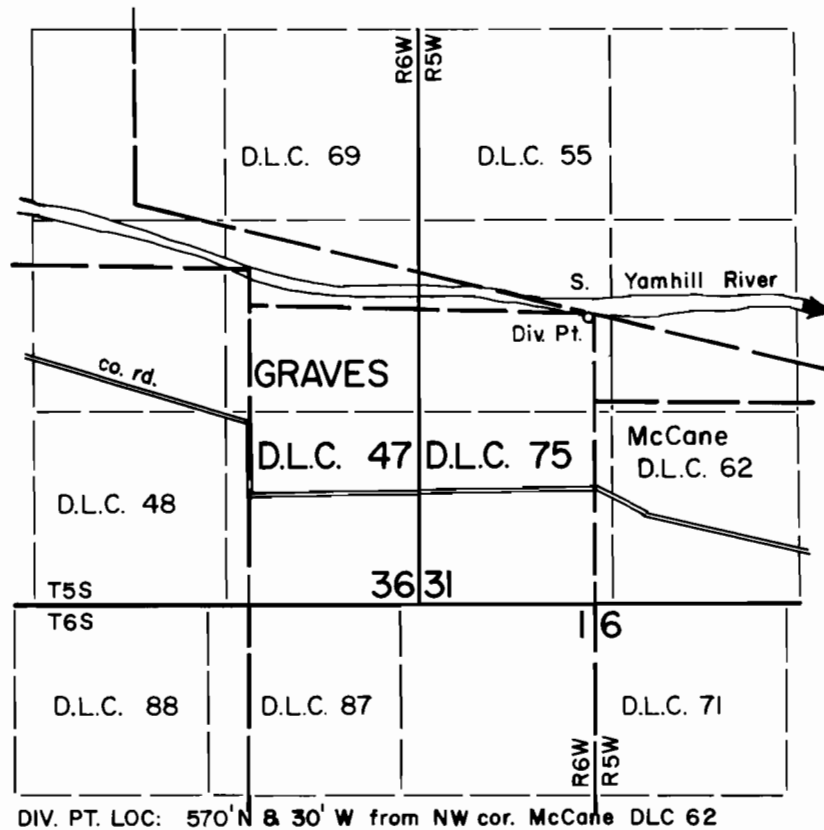

FINAL PROOF SURVEY UNDER

Transfer No. 3013

Application No. Permit No.

IN NAME OF

GRACE STUTZMAN

Surveyed July 7 1976, by L.H. Nunn