


RECEIVED

MAY 7 1974

STATE ENGINEER
SALEM, OREGON

SOUTH, RANGE 13 EAST, W.M.


T 3034

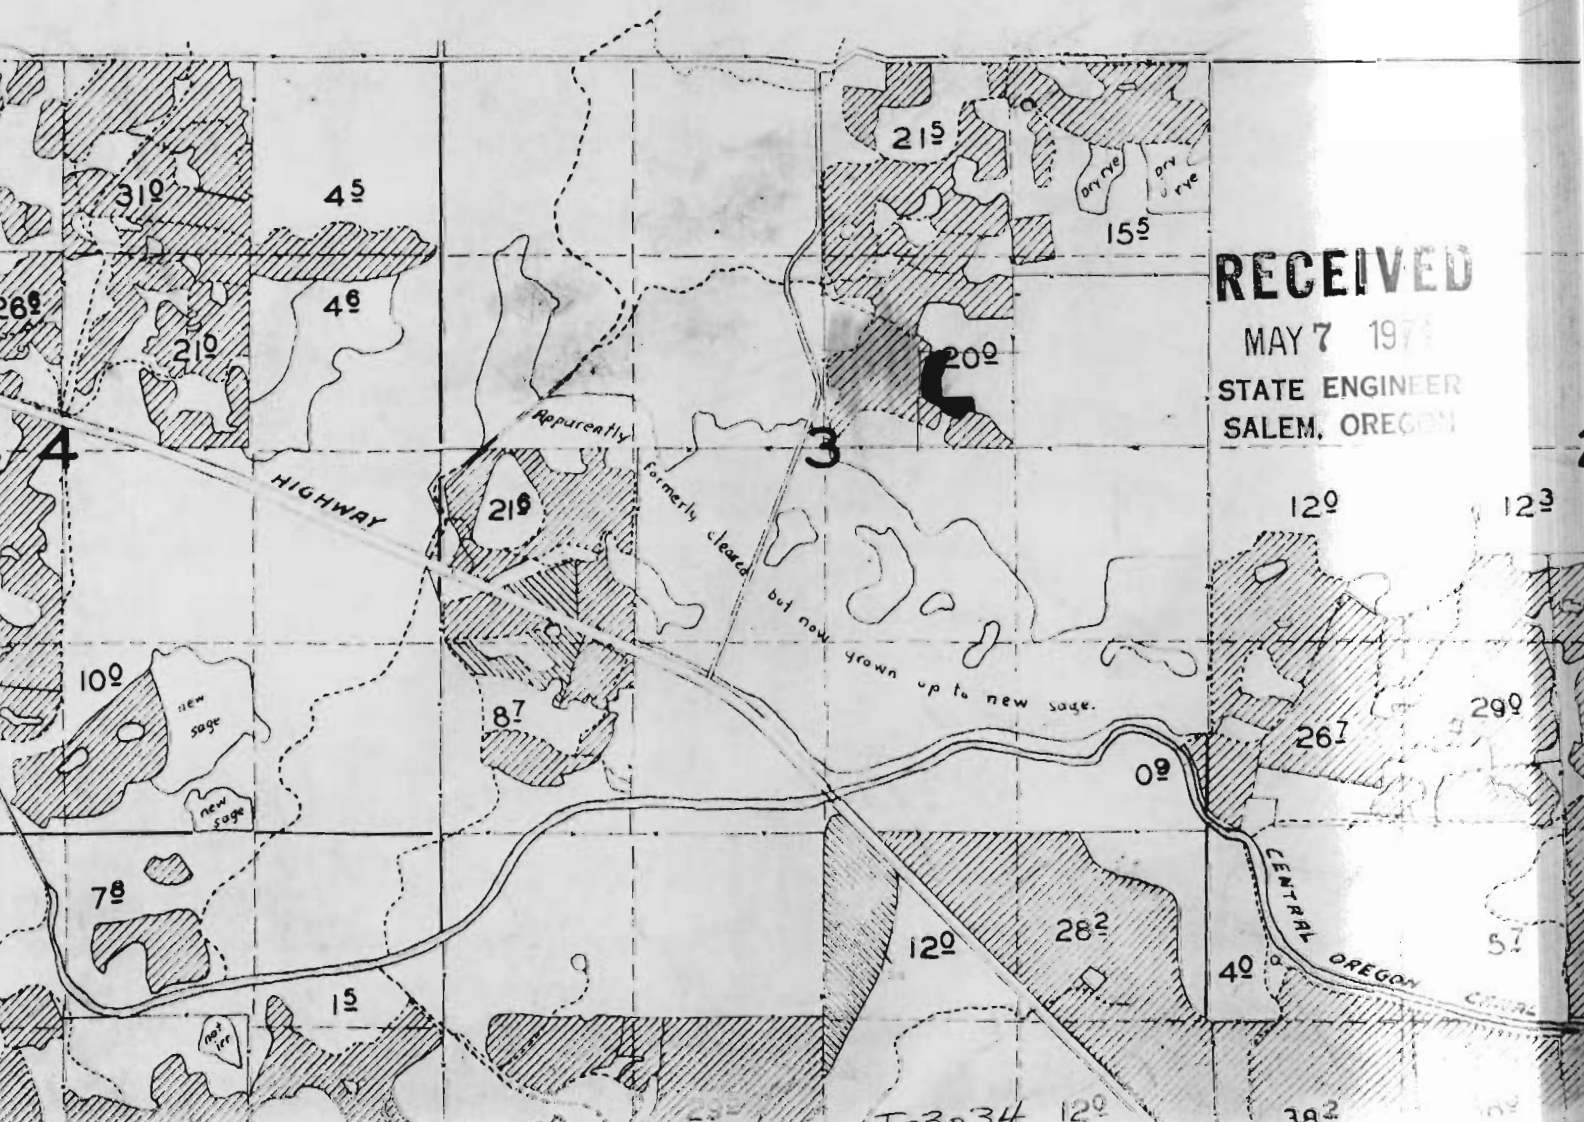

RECEIVED


STATE ENGINEER
SALEM, OREGON

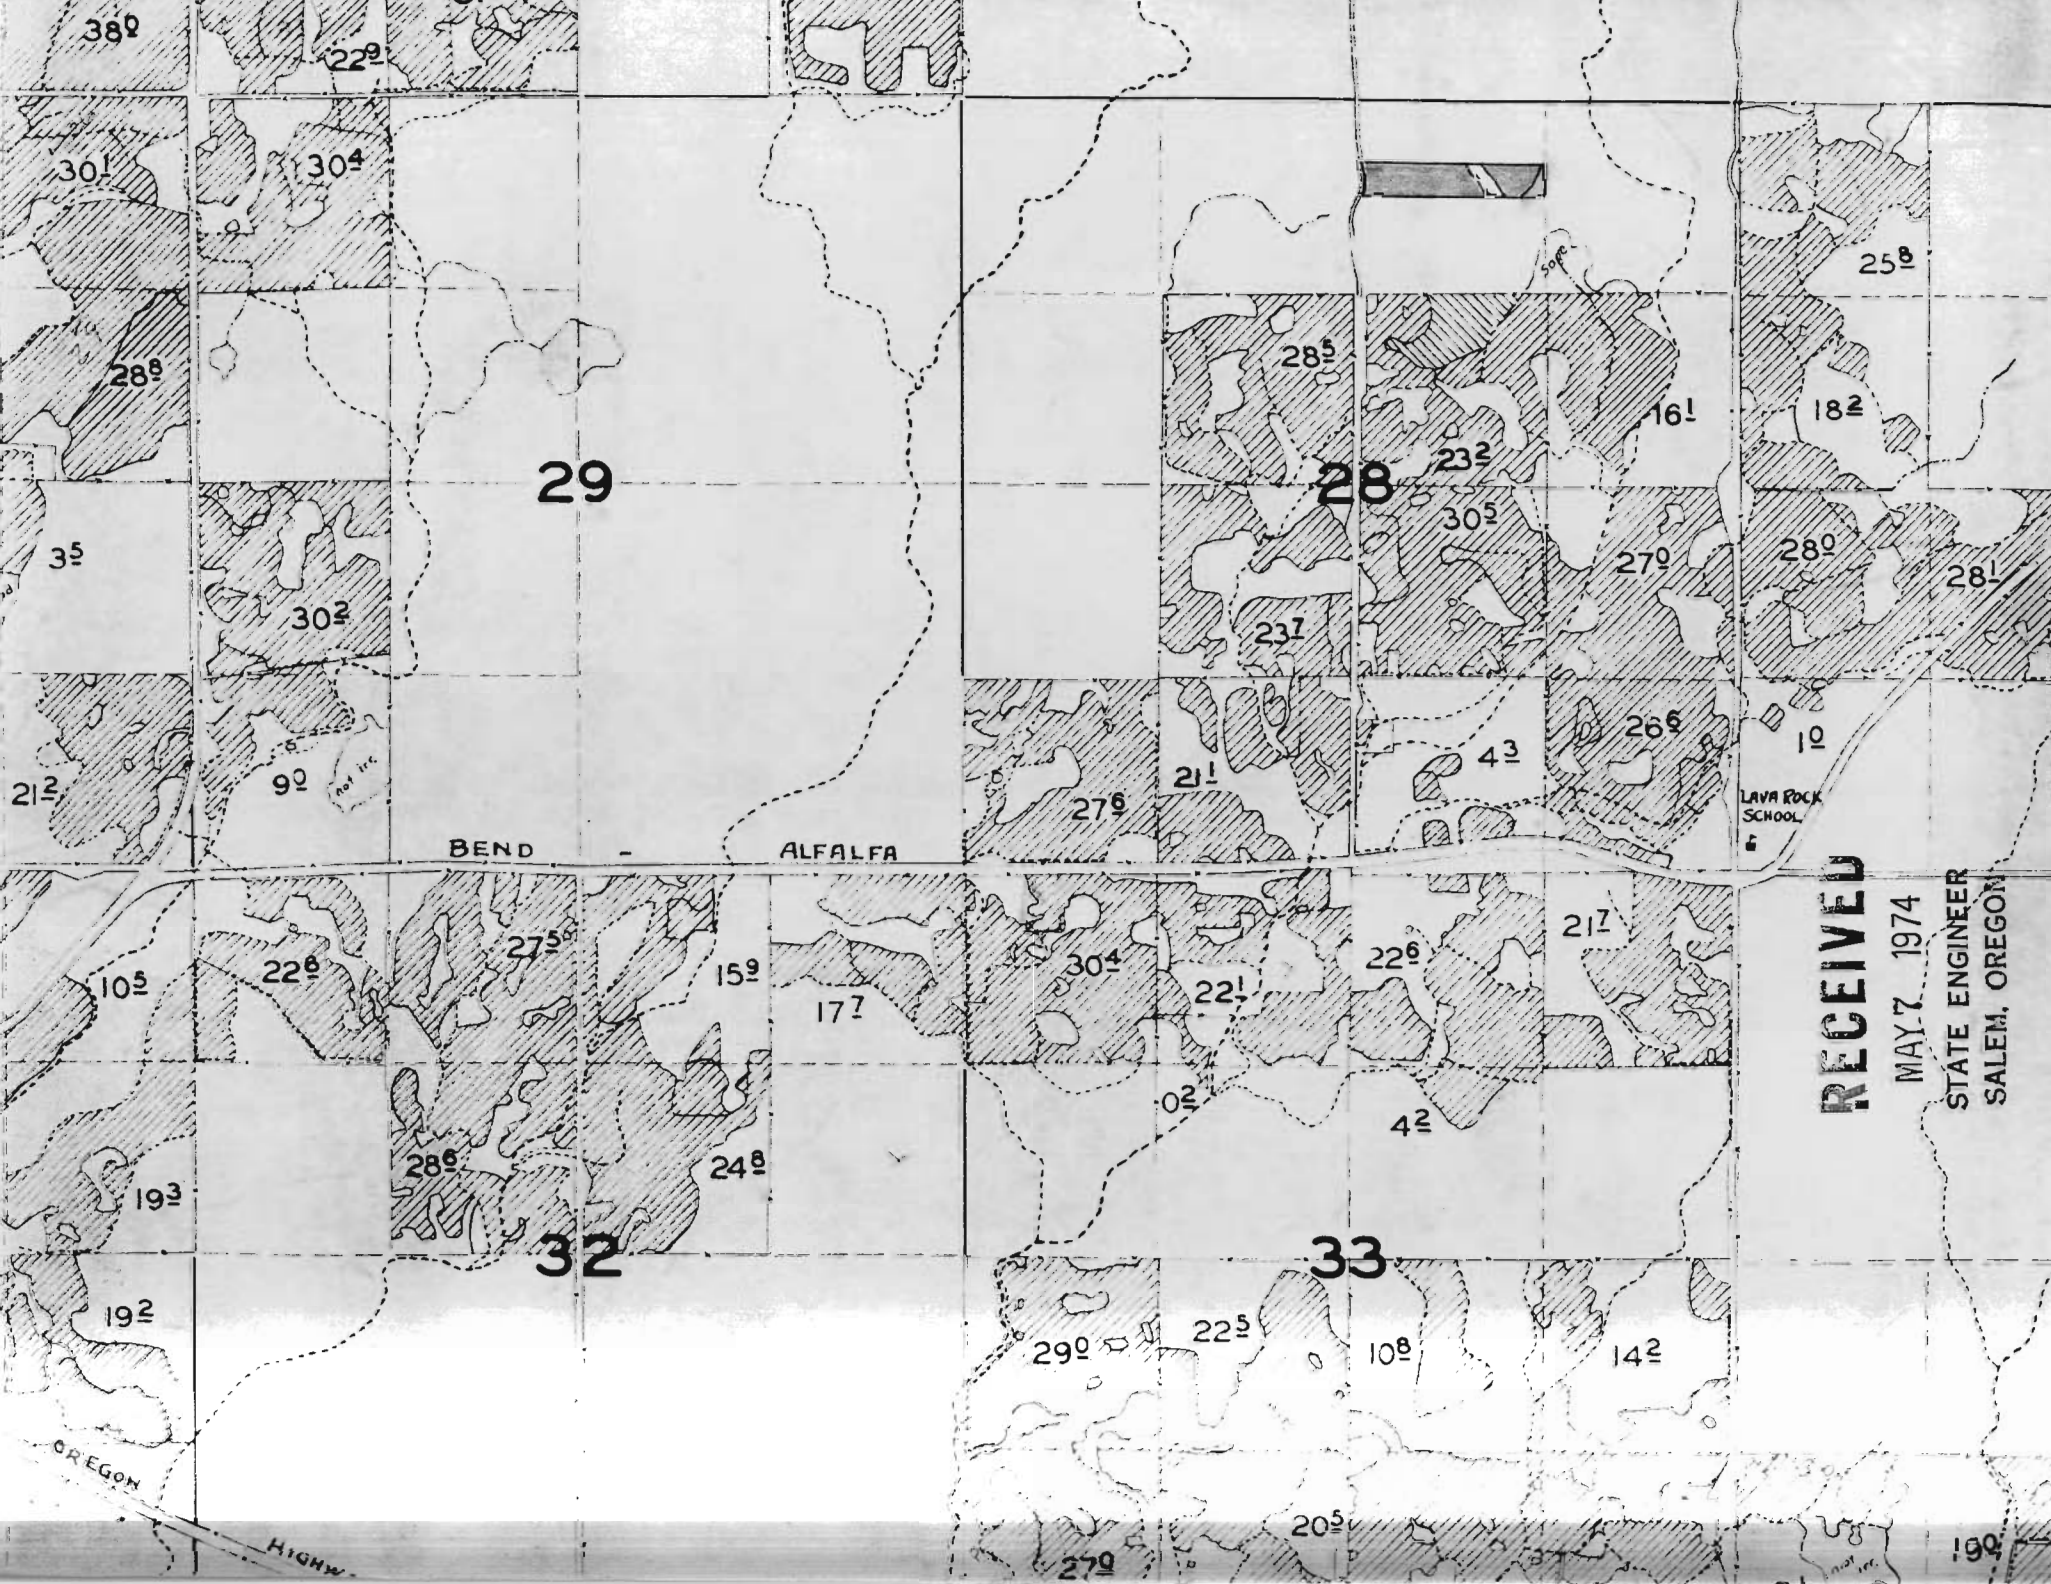

29

28

32

33

BEND

ALFALFA


LAVA ROCK SCHOOL

OREGON
HIGHWAY

RECEIVED

MAY 7 1974
STATE ENGINEER
SALEM, OREGON

38⁰ 22⁹ 30¹ 30⁴ 28⁸ 29 28⁵ 23² 16¹ 25⁸ 18² 35 30² 27⁰ 28⁰ 28¹ 21² 9⁰ 27⁶ 21¹ 4³ 26⁶ 10 21² 10⁵ 22⁶ 27⁵ 15⁹ 17⁷ 30⁴ 22¹ 22⁶ 21⁷ 19³ 28⁶ 24⁸ 0² 4² 19² 19² 29⁰ 22⁵ 10⁸ 14² 27⁹ 20⁵ 19⁰

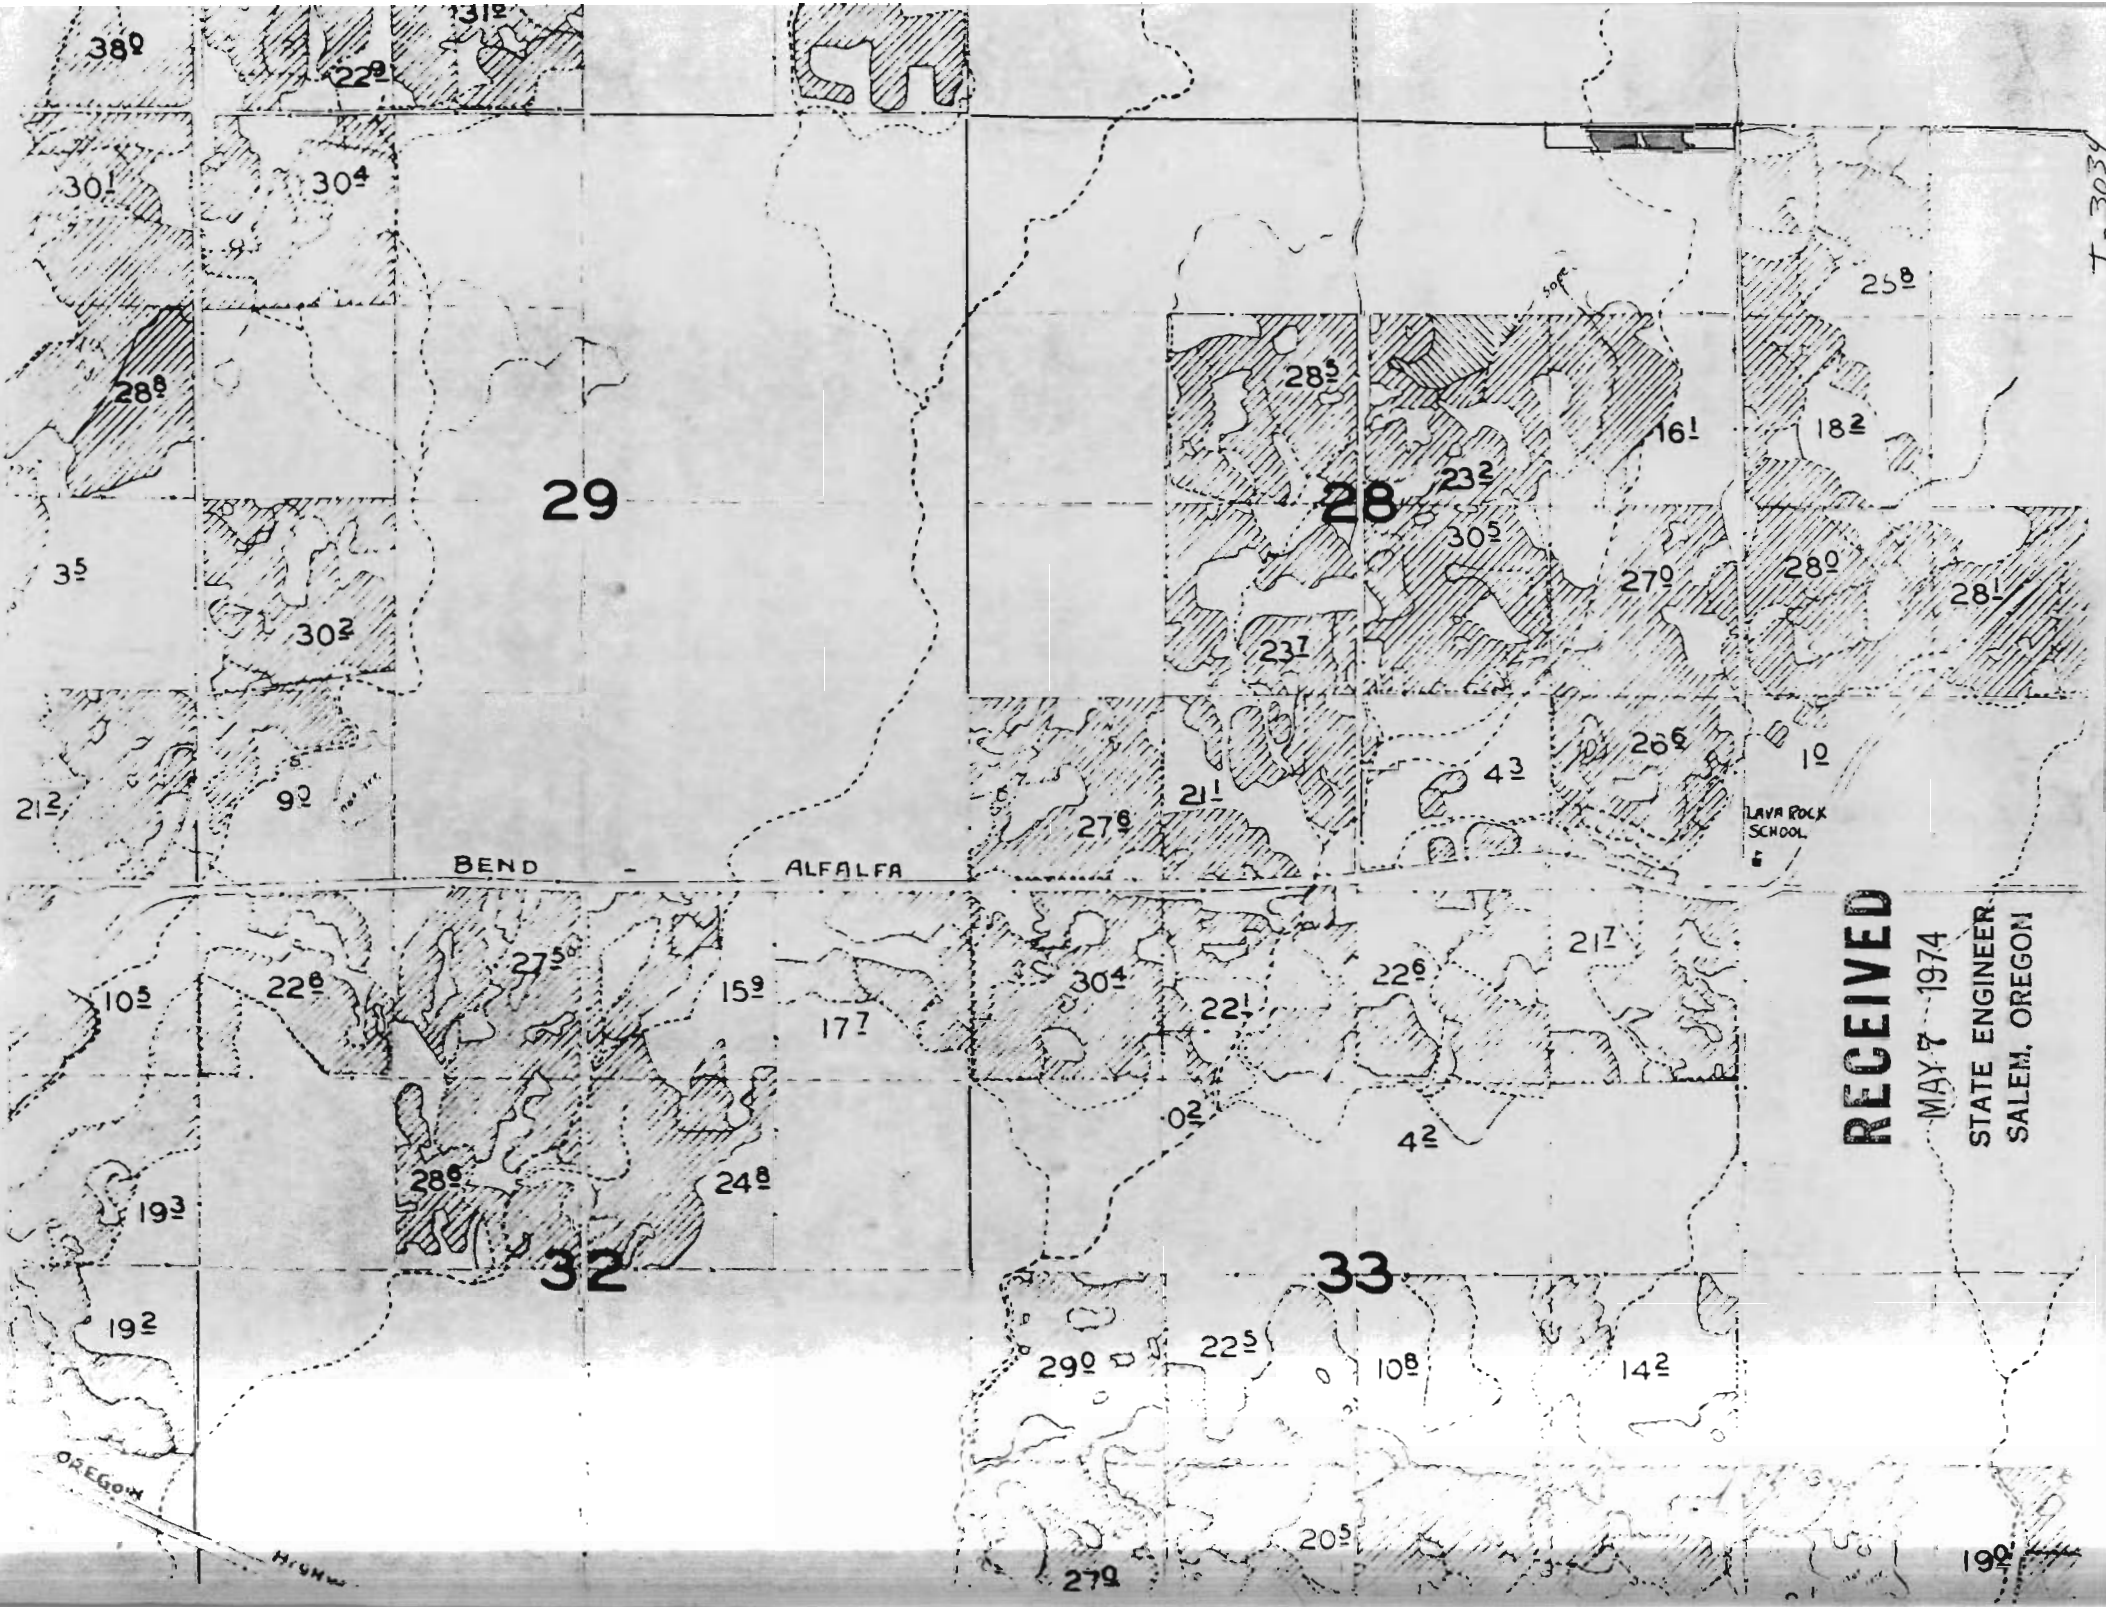

RECEIVED

MAY 7 1974
STATE ENGINEER
SALEM, OREGON

T-3039