


T.I.O.S.R.6W.W.M.

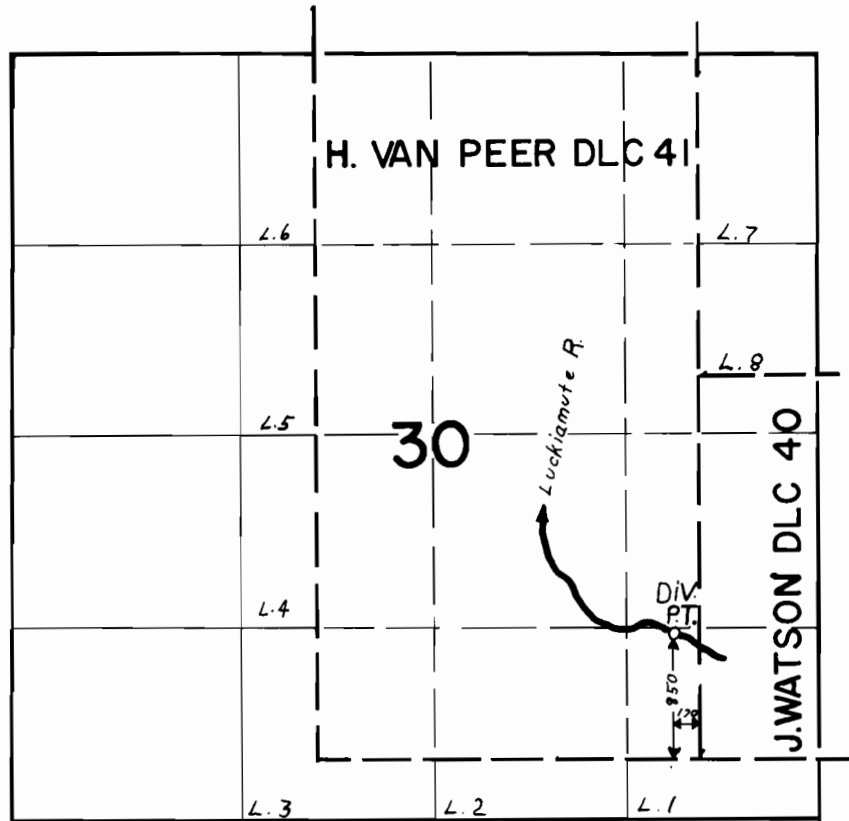

FINAL PROOF SURVEY UNDER

Transfer No. 3035

Application No. _____ Permit No. _____
IN NAME OF

JAMES H. JOHNSON

Surveyed MAR. 29, 1976, by C.R. KING