

31
Hansen & Sons - New Owner Joe Berger


21-16-12

Note

SECTION T. S. R. E.W.M.

Remove 8 acres from ~~west~~ side of SE NW
to west side NW NW

This was done by transfer # 2545

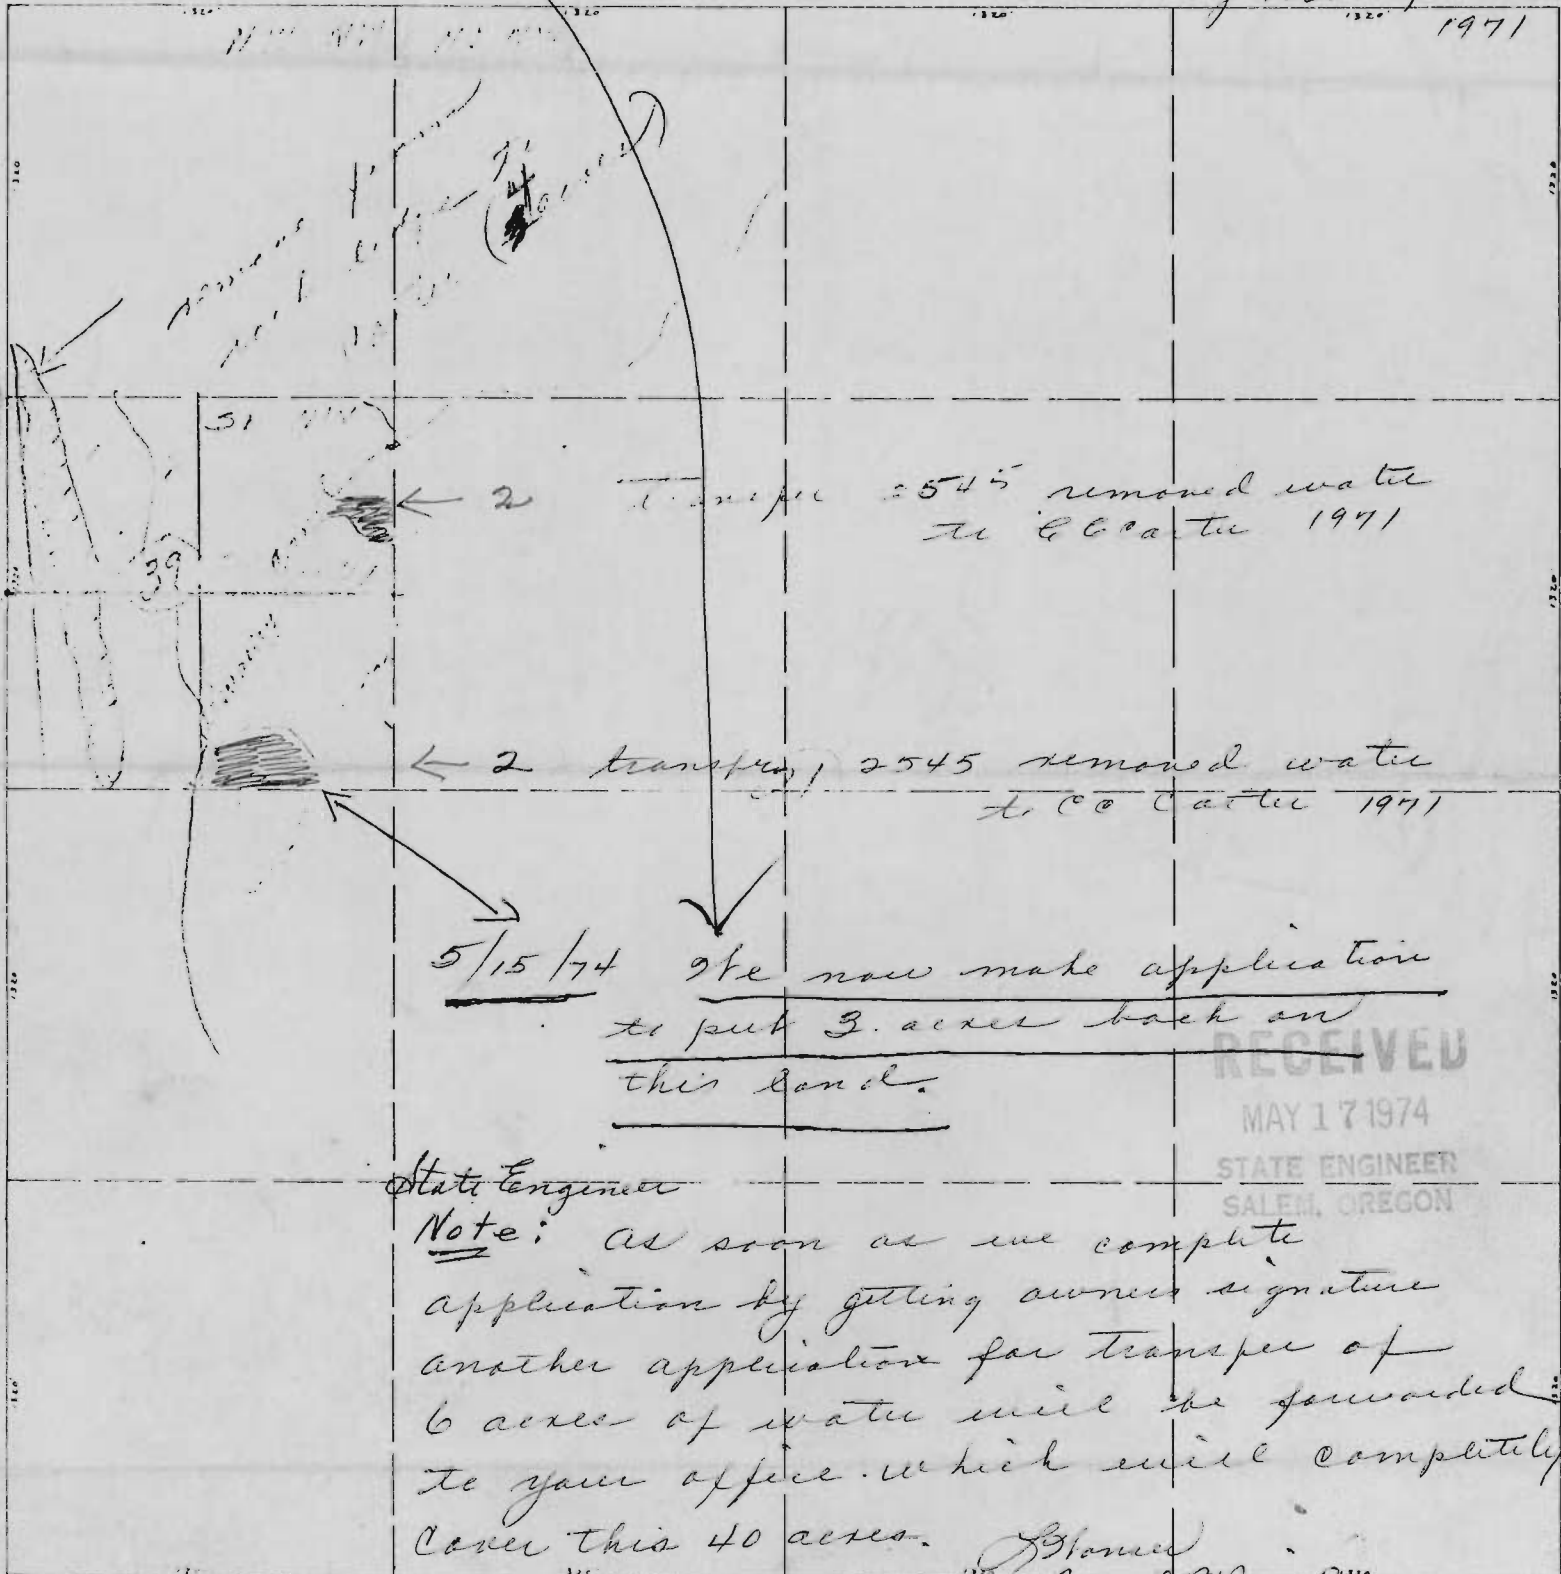

← 2 Transfer 2545 removed water to C.C. Carter 1971

← 2 Transfer 2545 removed water to C.C. Carter 1971

5/15/74 We now make application to put 3 acres back on this land.

State Engineer

Note: As soon as we complete application by getting owners signature another application for transfer of 6 acres of water will be forwarded to your office which will completely cover this 40 acres.

Hansen
See P.A. Day Co

RECEIVED
MAY 17 1974
STATE ENGINEER
SALEM, OREGON

NE 1/4, NW 1/4, SEC. 8, T.17S., R.12E., W.M.

Kitch Ramsey Sr.

T-3046

RECEIVED
MAY 17 1974
STATE ENGINEER
SALEM, OREGON

Leaving 4 1/2

(12.1 ACRES)

*7 1/2 acres of water on 12.1 land
3 " " " " to be transferred
to 21-16-12*

*Areas to
be transf.*

*BEND-SISTERS
Hwy. # 20*

OLD BEND-REDMOND HWY.

(1.7 AC.)

