


# T. 36 S., R. 1 W., W.M.

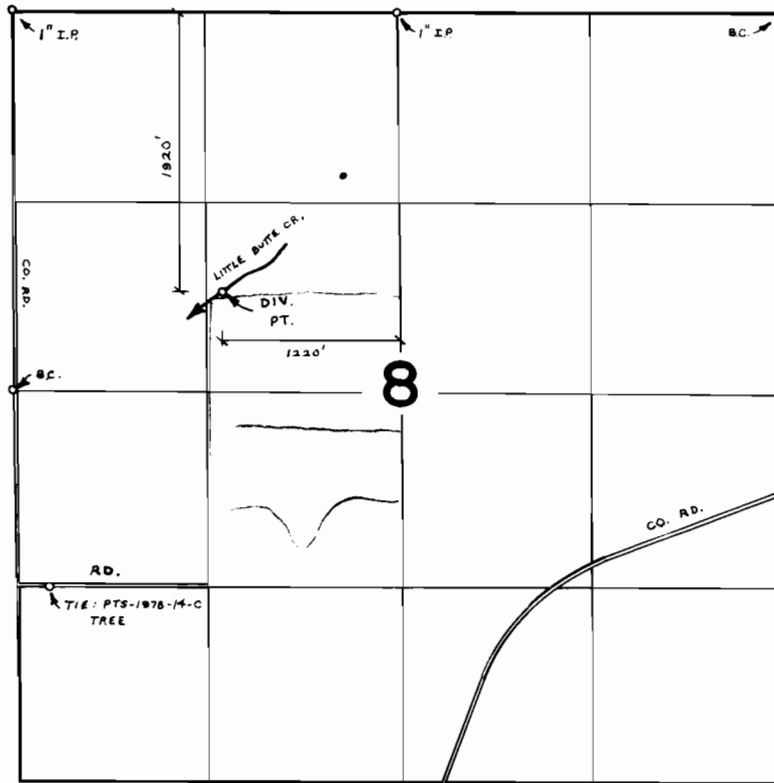

## FINAL PROOF SURVEY UNDER

Application No. TR-3049 Permit No.                       
IN NAME OF

TIMOTHEUS J. HORN

Surveyed AUG. 22 1978, by B. SUND