


T. 15., R. 43E., W. M.

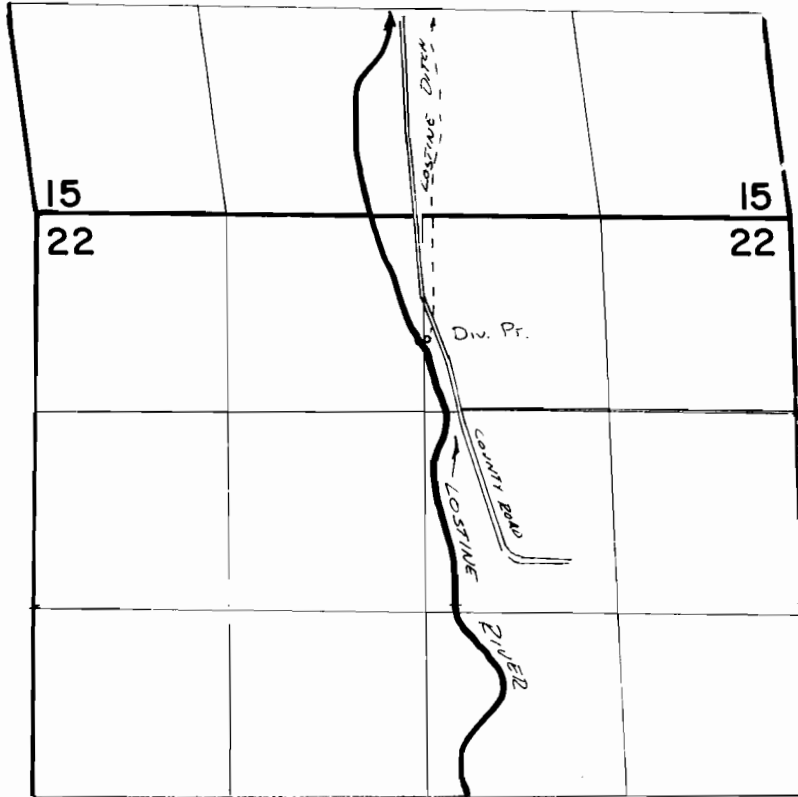

Div. Pt. loc: 830' S + 2700' E. FROM NW COR. SEC 22.

**FINAL PROOF SURVEY**  
UNDER

**TRANSFER 3053**

IN NAME OF

.....**RICHARD HAGANAH**.....

Surveyed *Apr. 10* 19*82*, by *V.L. Church*