


# T.6S. R.IE., W.M.

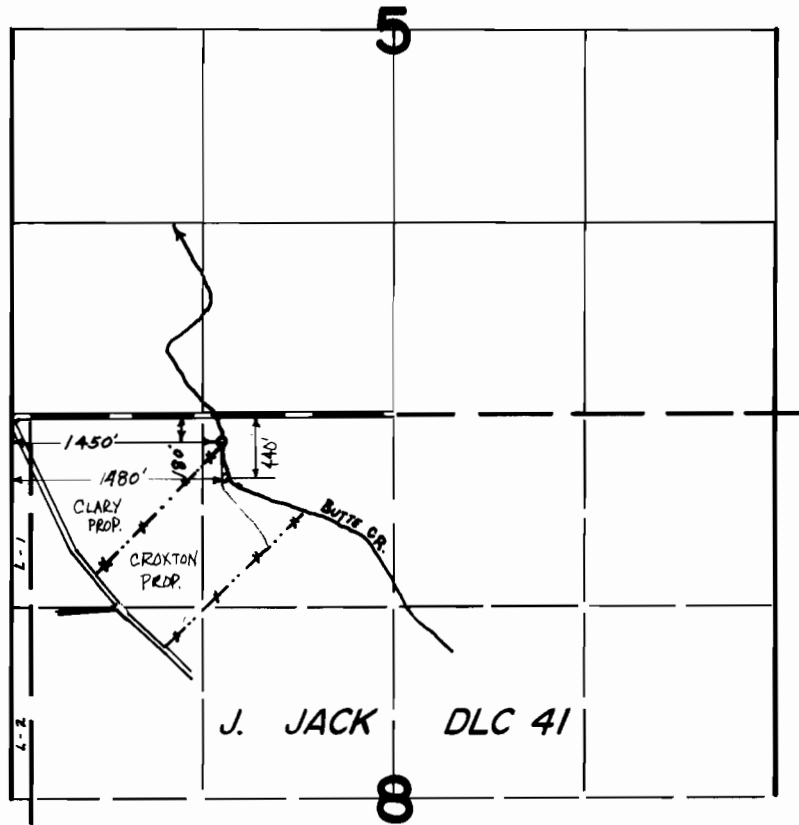

## FINAL PROOF SURVEY UNDER

Transfer No. 3058

IN NAME OF

PIRFIL CAM

Surveyed JUNE 6, 1979, by L. H. NUNN  
NOV. 9, 1983 M. CAHILL