


T. 1 S. R. 43 E. W.M.

13

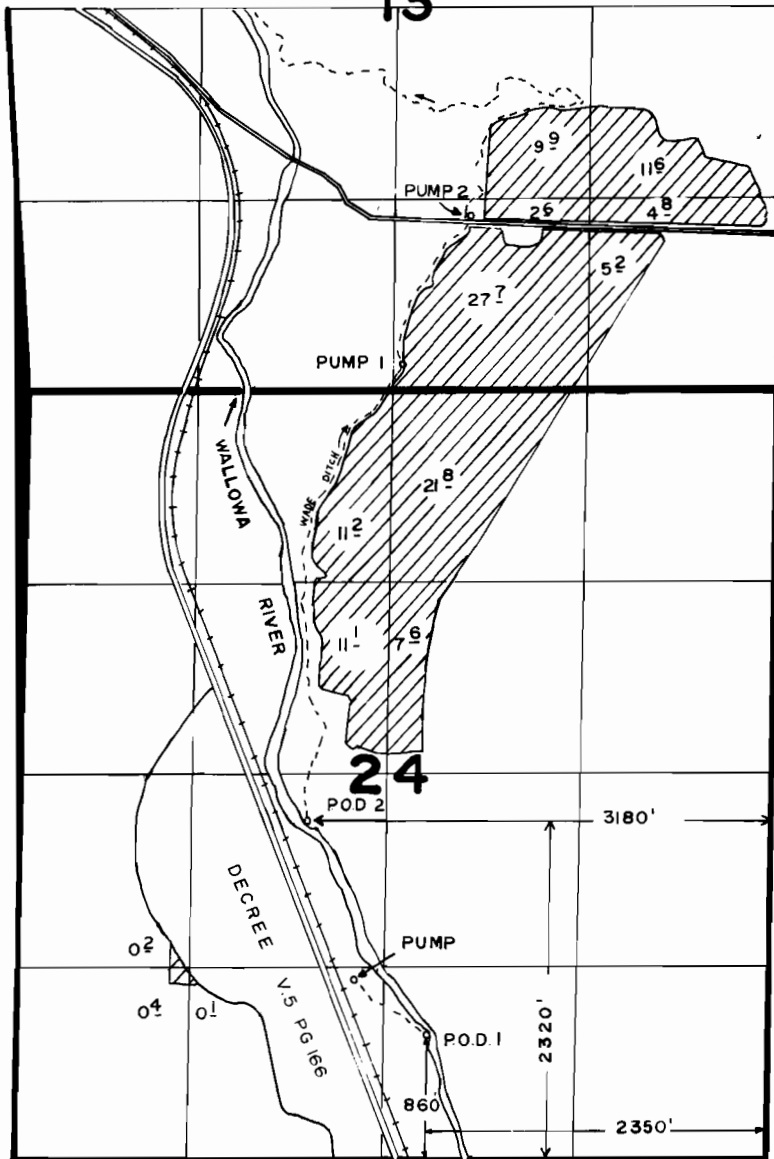

Scale 1" = 1320'

FINAL PROOF SURVEY UNDER

TRANSFER 3059

Application No. 55 236 Permit No. 41469

IN NAME OF

MERTON WADE

Surveyed AUGUST 10 19 82, by V. CHURCH

AUGUST 28 1985 V. CHURCH