


T. 7 S. R. 39 E. W.M.

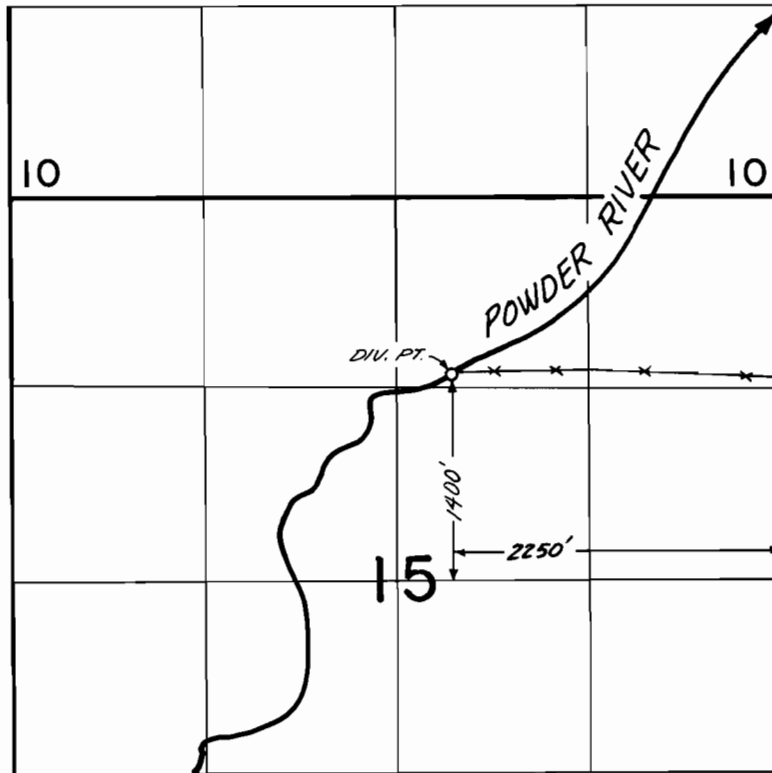

FINAL PROOF SURVEY
UNDER

TRANSFER 3068
Application No. Permit No.
IN NAME OF

BURR COURTRIGHT

Surveyed JUNE 24 1976, by CRKING