


T. 7 S. R. 39 E. W. M.

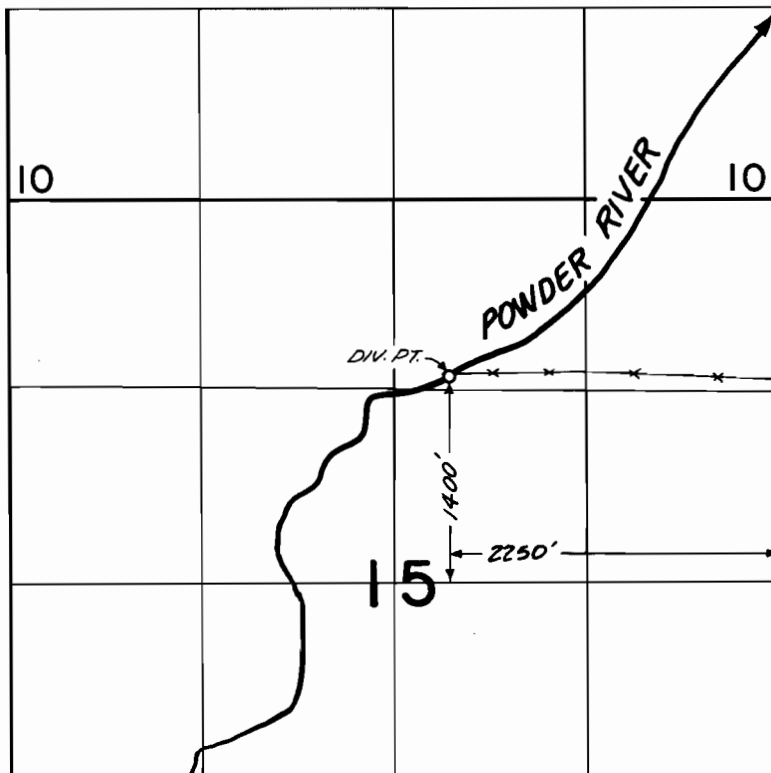

FINAL PROOF SURVEY UNDER

TRANSFER 3070
Application No. _____ Permit No. _____
IN NAME OF

LENN C. & MIRIAM M. HOLMAN

Surveyed JUNE 24 1976, by C.R. KING