


T.26S., R.4W., W.M.

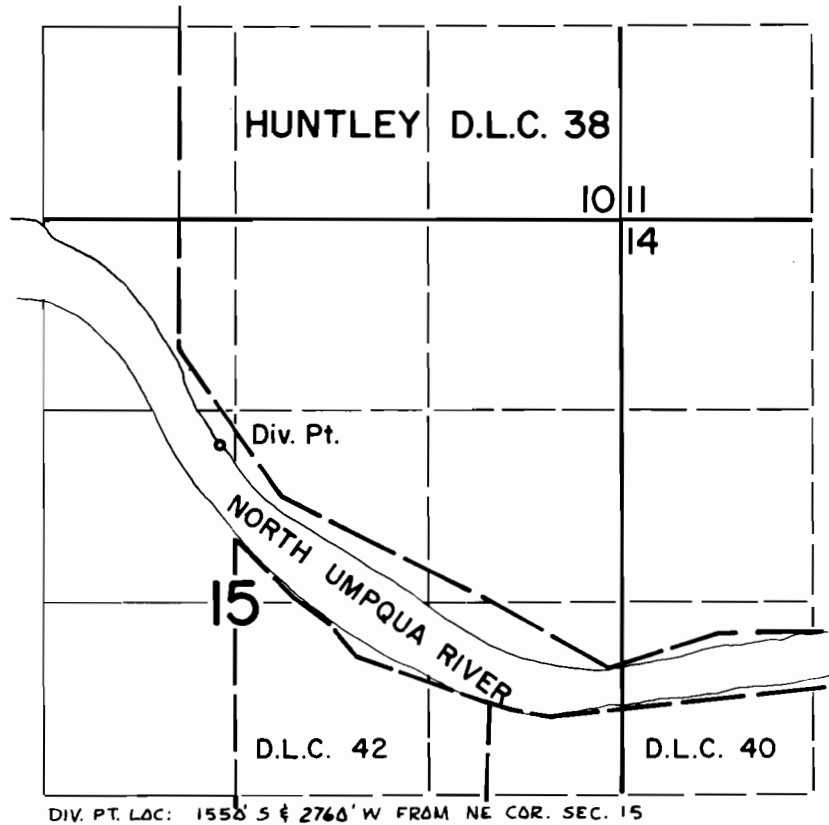

FINAL PROOF SURVEY
UNDER

Transfer No. 3071

Application No. Permit No.
IN NAME OF

FRANK J. HORN

Surveyed Sept. 2 1976, by D. Norby