


T. 4S., R. 39E., W. M.

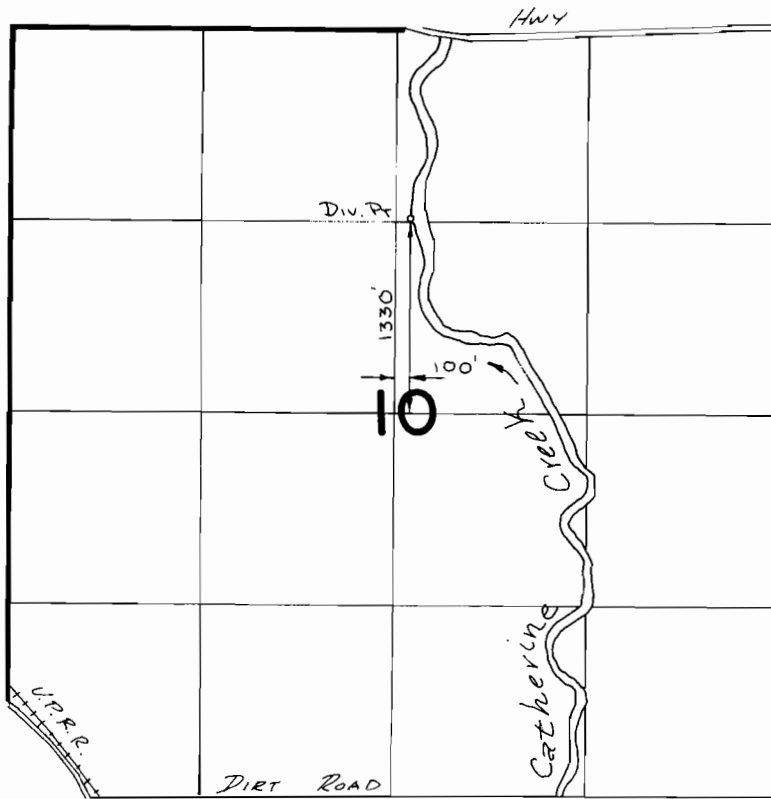

SCALE 1" = 1320'



FINAL PROOF SURVEY
UNDER

TRANSFER 3079
IN NAME OF

.....**LEONARD**.....**HUFFMAN**.....

Surveyed ...7-10... 1984, by ...V.L. Church...