

43091

Transfer from Ralph W. Boese to Don E. Courtney 5 acre water right.


SECTION 1 T.18S. R.12E.W.M.
DESCHUTES COUNTY

dead numbers 400

18 12 1

1"=400'

See Map 17 12 36

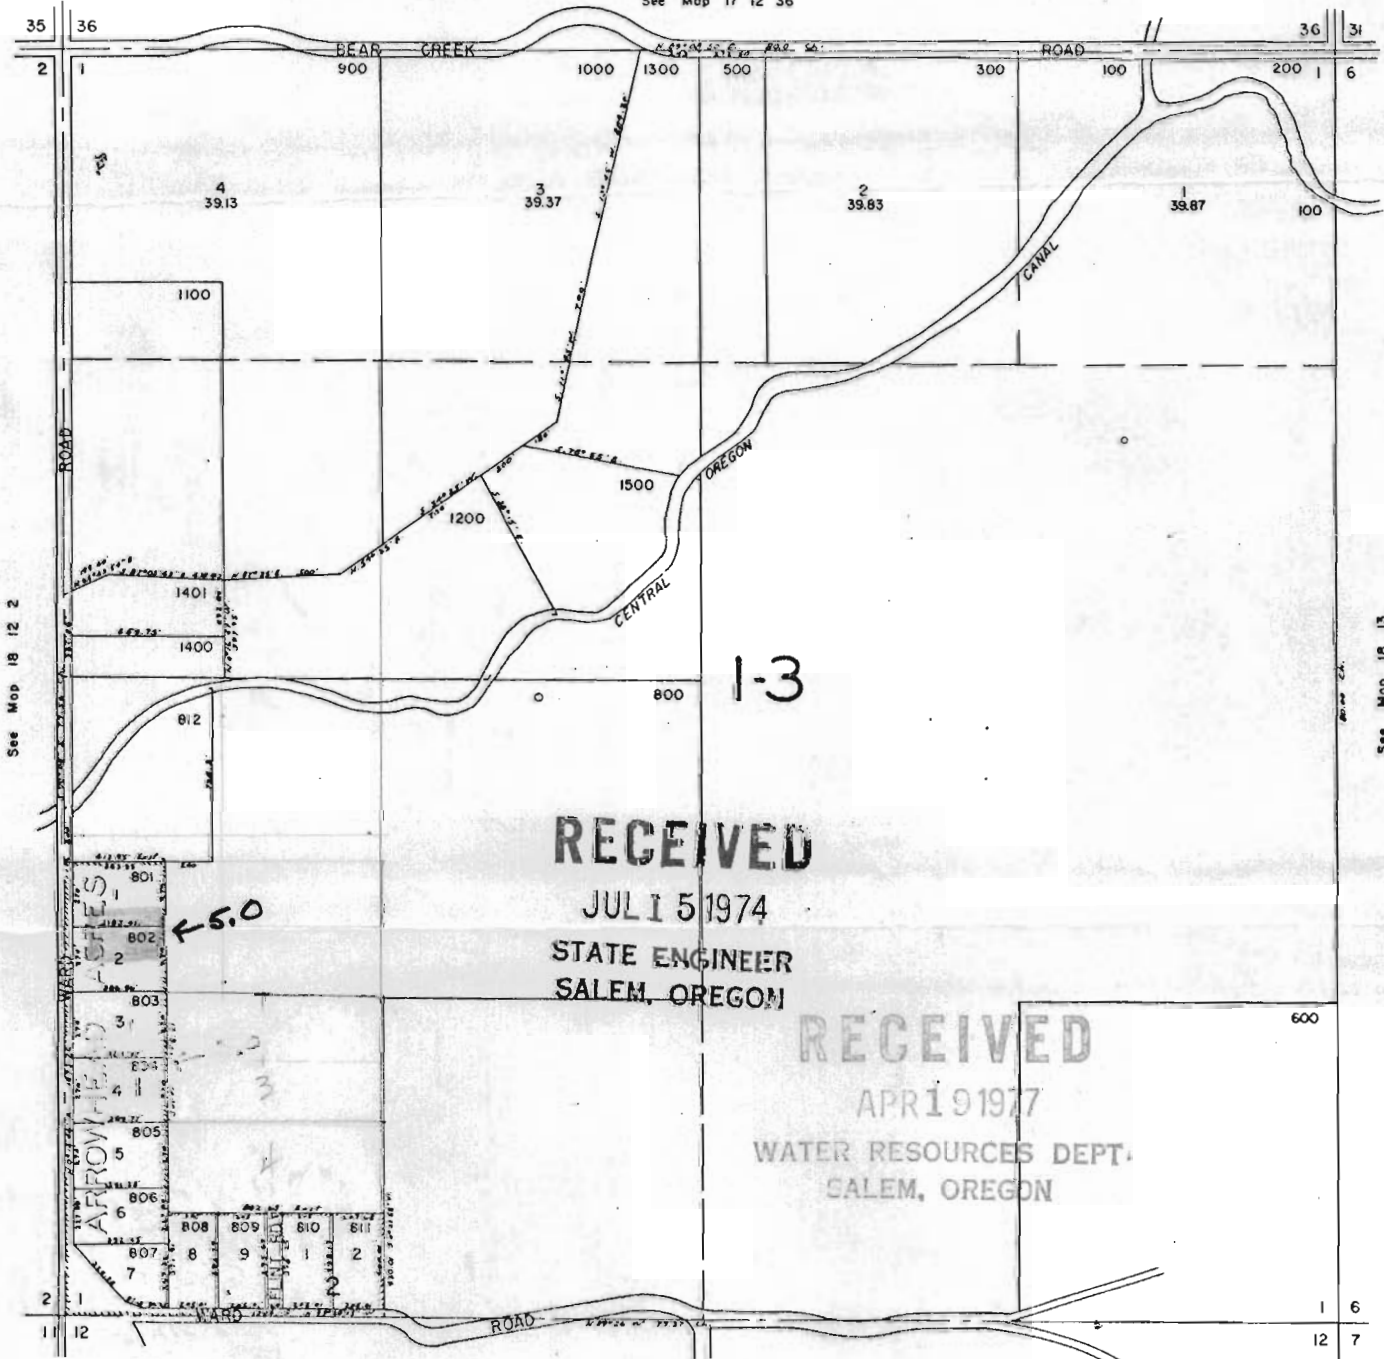

RECEIVED

JUL 15 1974

STATE ENGINEER
SALEM, OREGON

RECEIVED

APR 19 1977

WATER RESOURCES DEPT.
SALEM, OREGON

5 ac. water right to be transferred off the above land - SW¹/₄ NW¹/₄ SW¹/₄ Sec.1 T18S.12 E WM
colored red.

18 12 1

T-3091