


T. 35 S., R. 1 W., W.M.

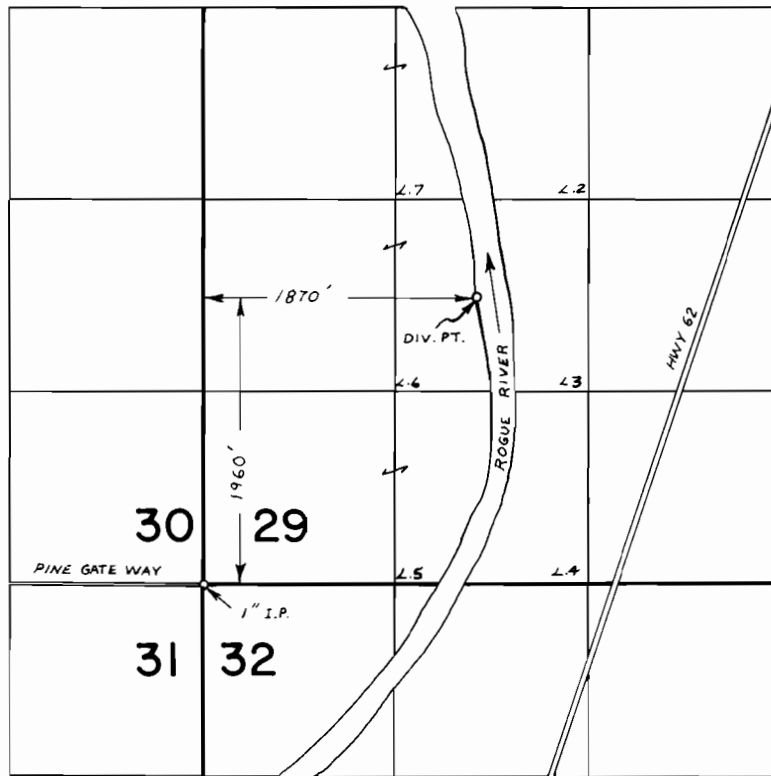

FINAL PROOF SURVEY UNDER

Transfer No. 3094

Application No. Permit No.

IN NAME OF

ROBERT S. GRIFFIN

Surveyed MAY 23 1978, by B. SUND