


T. 34 S., R. 3 W., W.M.

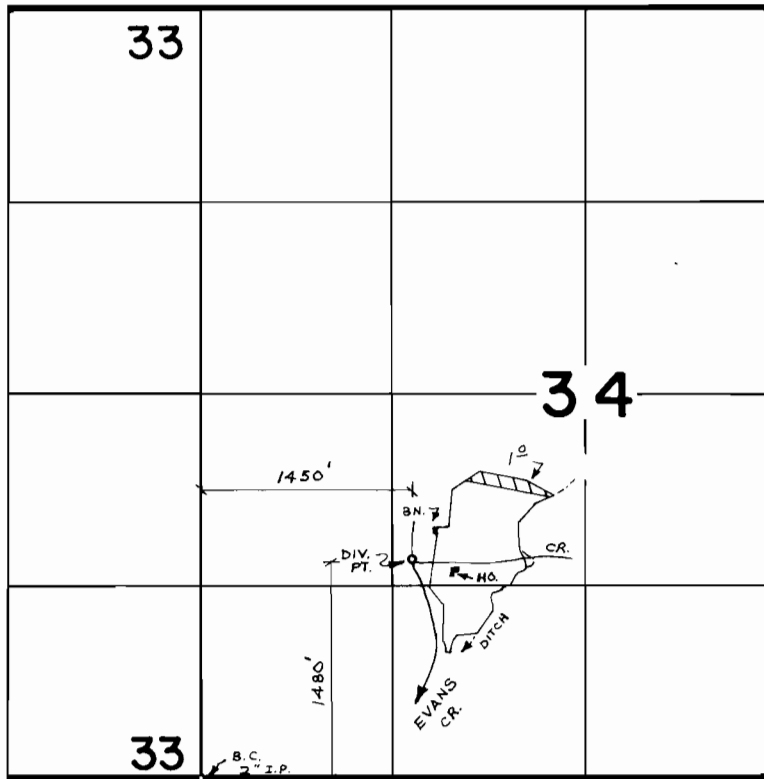

FINAL PROOF SURVEY
UNDER

Application No. TR. 3098 Permit No.
IN NAME OF

W. H. & NATALIE JOSLIN HALL

Surveyed DEC. 21 1977, by B. SUND