



T.3S., R.4W., W.M.

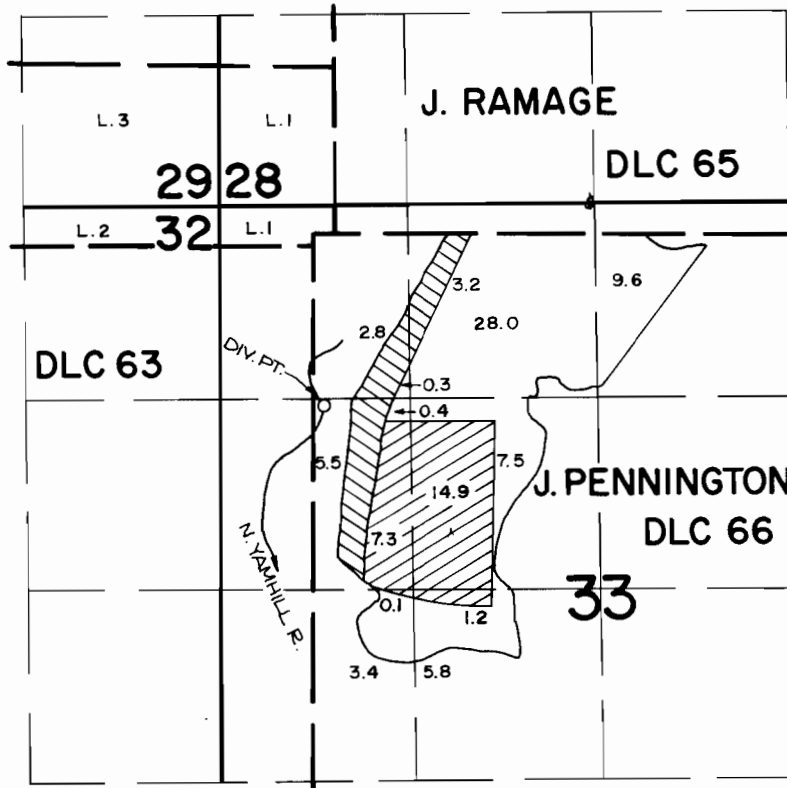

DIV. PT. LOCATION: 1360 FT. S. AND 710 FT. E. FROM THE N.W. CORNER OF SECTION 33.

 PRIORITY DATE: MAY 16, 1939

 PRIORITY DATE: APRIL 25, 1941



FINAL PROOF SURVEY UNDER

SCALE: 4" = 1 MILE

TRANSFER NO. 3099

IN NAME OF

.....**ALLAN & LOUISE KATZ**.....

Surveyed JULY 9, 1984, by *P. Doster*