


T.5S., R.1W., W.M.

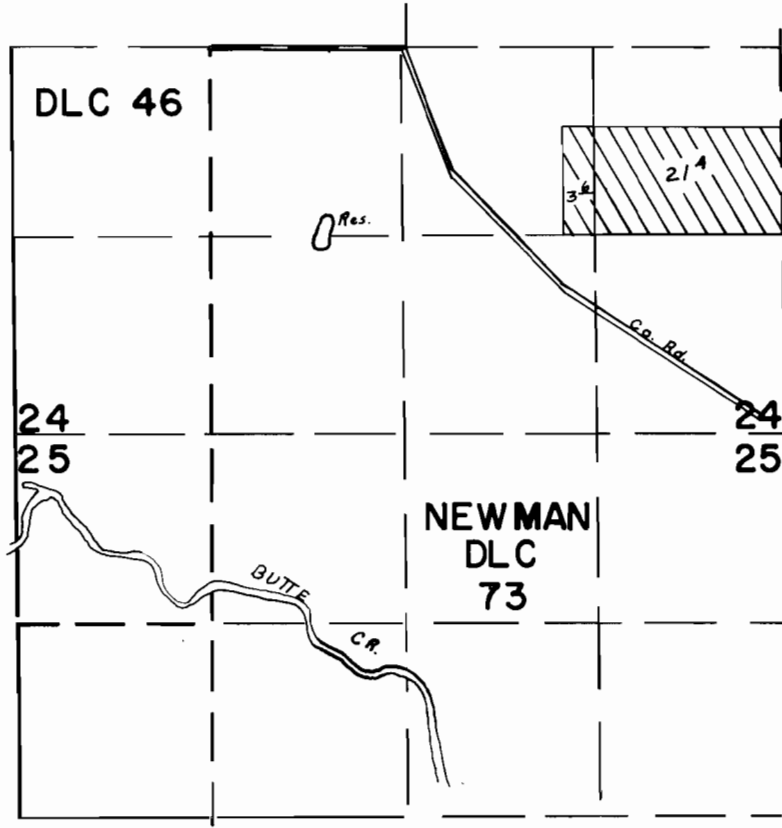

FINAL PROOF SURVEY
UNDER

Transfer No. 3100
Application No. Permit No.
IN NAME OF

..... **ROSS IVERSON**

Surveyed JUNE 1 1977, by D.M. NORBY