


# T.6S., R.6W., W.M.

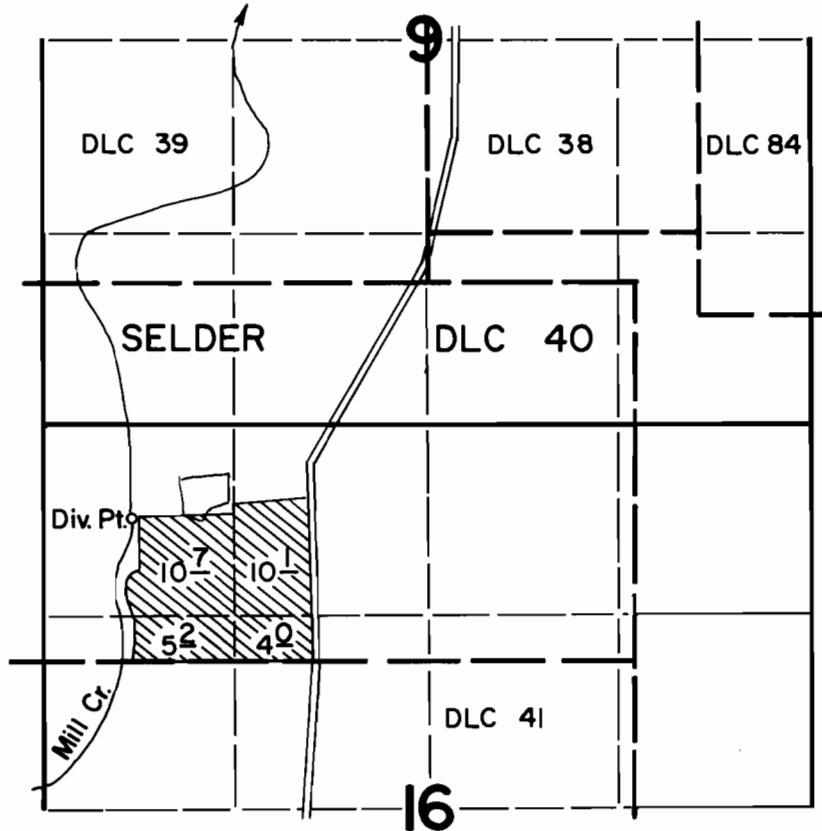

DIV. PT. LOC: 650' S & 610' E from NW cor. sec. 16

## FINAL PROOF SURVEY UNDER

Transfer No. 3111

Application No. .... Permit No. ....

IN NAME OF

TOIVO J. SIMONSON

Surveyed Oct. 22 1976, by D. Norby