

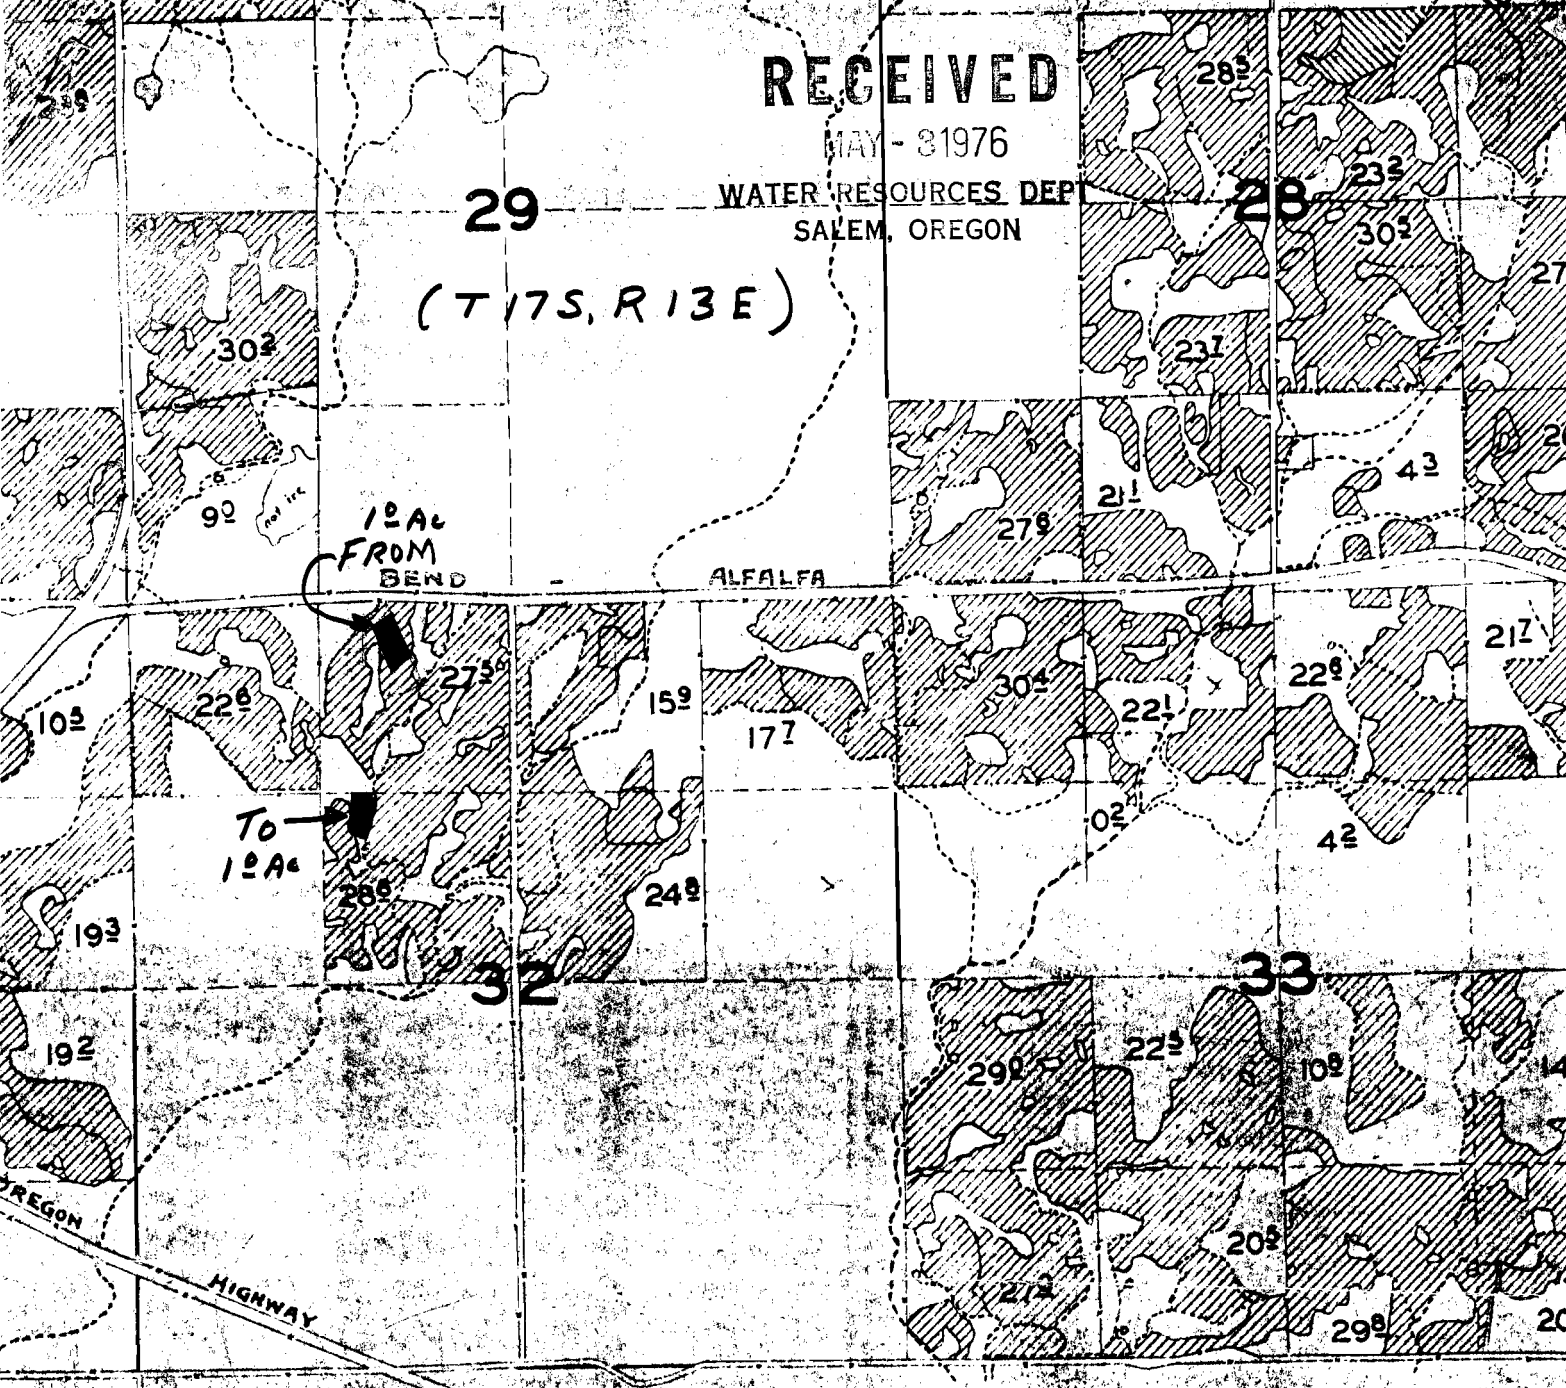
RECEIVED



MAY - 8 1976

WATER RESOURCES DEPT
SALEM, OREGON

29

(T 17S, R 13E)



To be transferred from 
 To be applied to 

RECEIVED

AUG 16 1974

STATE ENGINEER
SALEM, OREGON