


T. 35 S., R. 3 W., W.M.

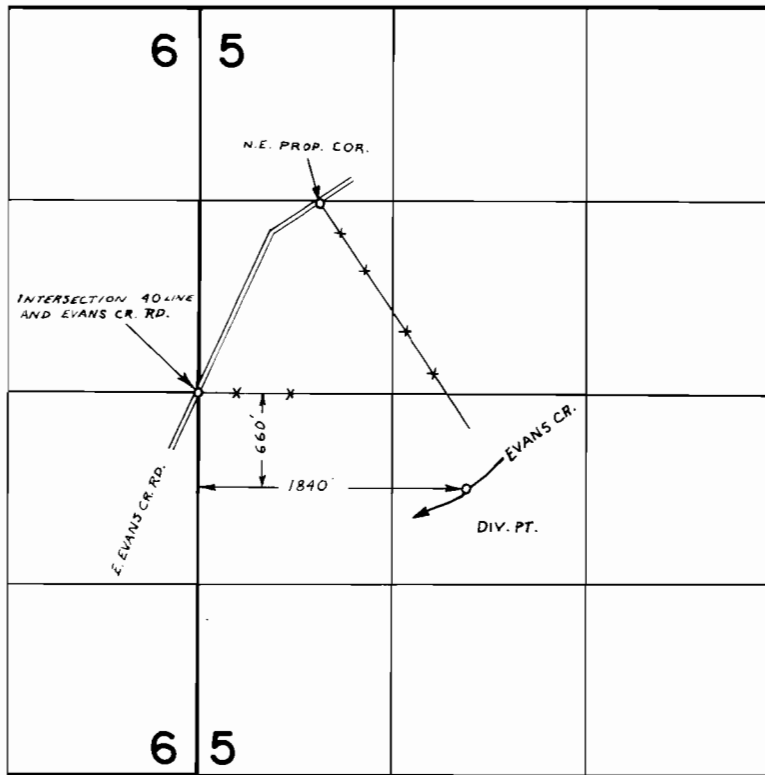

FINAL PROOF SURVEY
UNDER

TR-3118

Application No. TR-3117 Permit No.
IN NAME OF

EARL E. & MERRY J. SAMSON

Surveyed APR. 13 1978, by B. SUND