


T.2N., R.31&32E., W. M.

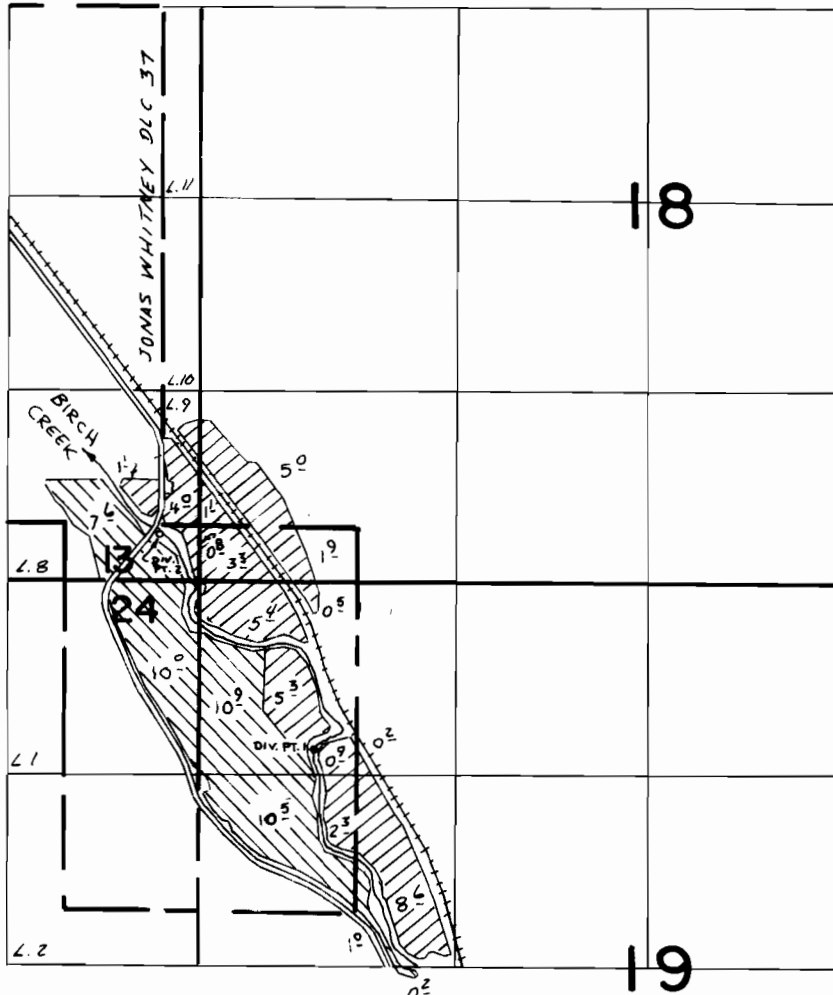

DIVERSION POINT 1 LOCATED 1140' S. & 790' E. FROM NW COR SEC 19
DIVERSION POINT 2 LOCATED 320' N. & 270' W. FROM NW COR SEC 19



1895



1910

FINAL PROOF SURVEY

UNDER

TRANSFER 3122

IN NAME OF

JAMES M'BROOM

Surveyed 1-12-1984, by V. L. Church