



# T. 16 S., R. 11 E., W. M.

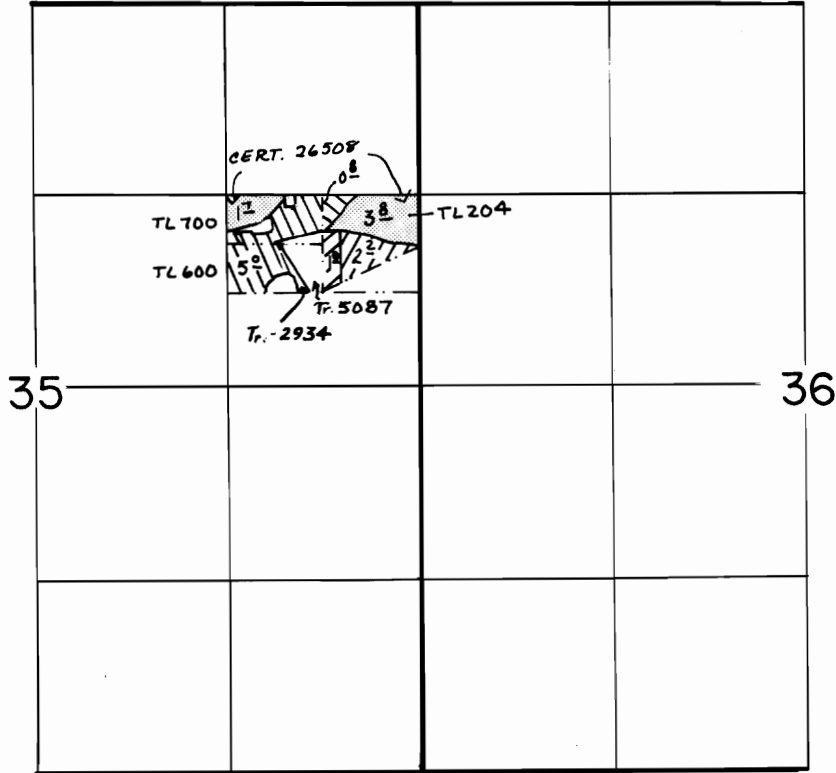

SCALE: 1"=1320'

## FINAL PROOF SURVEY UNDER

  
 TRANSFERS 3127, 5569, 5597, 5641  
1/3

IN NAME OF

..... LOUIS DVORAK .....

Surveyed ..MAY 10.. 1985., by ..L. OLSON.....  
JUNE 2, 1986