




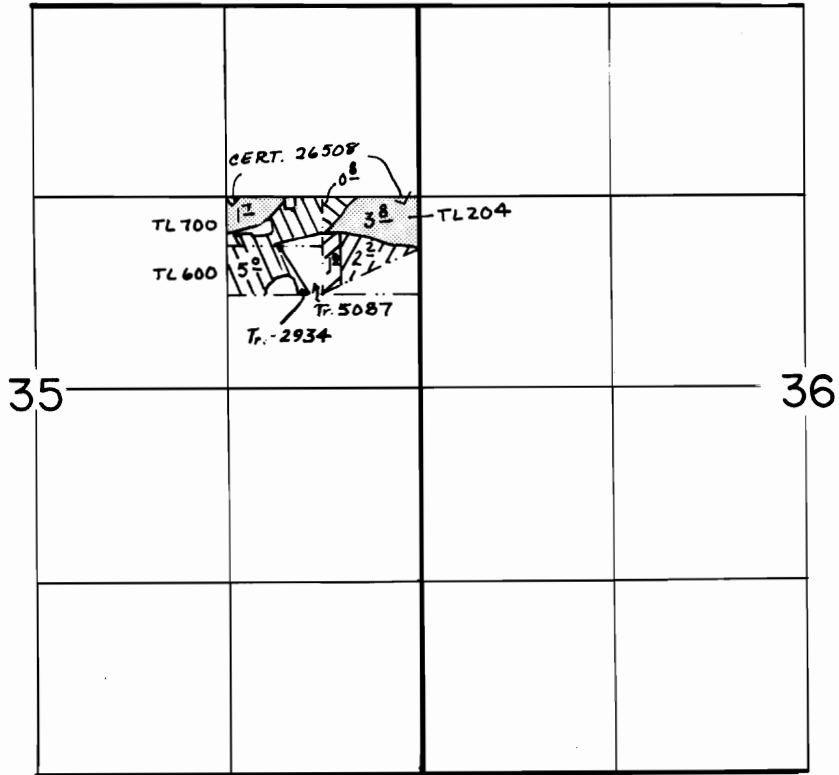

T.16 S., R.11 E., W.M.



SCALE: 1"=1320'

FINAL PROOF SURVEY UNDER





 TRANSFERS 3127, 5569, 5597, 5641
 1/3

IN NAME OF

.....LOUIS DVORAK.....

Surveyed MAY 10, 1985, by L. OLSON.....
JUNE 2, 1986