


T. 34 S., R. 1 W., W.M.
SEC. 28

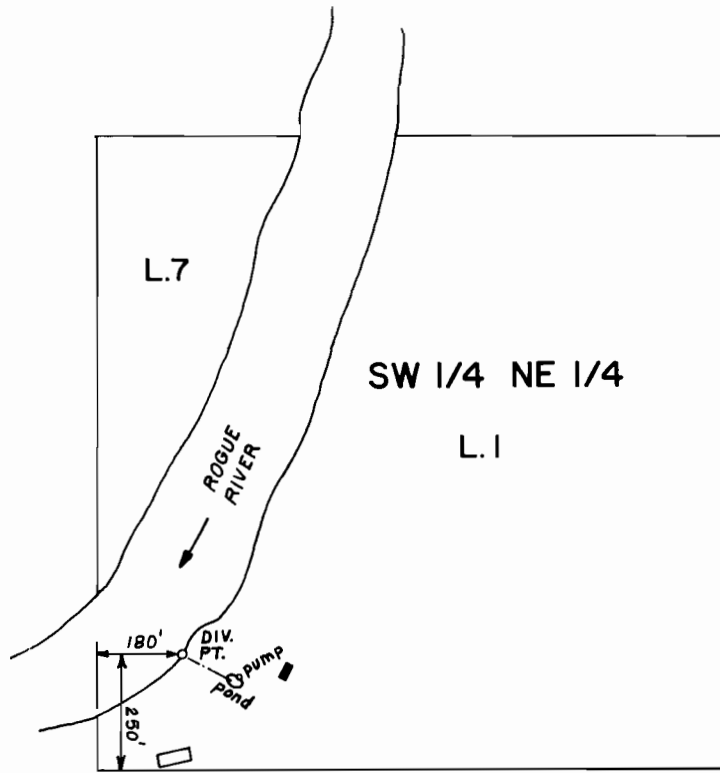

SCALE: 1" = 400'

FINAL PROOF SURVEY

UNDER

TRANSFER NO. 3422 & 3423

Application No. Permit No.

IN NAME OF

.....**MR. KAY PHILLIP SHUGART**.....

Surveyed **JULY 12, 1983**, by **B. S. JAMES**.....