


T.26S. R.3W. W.M.

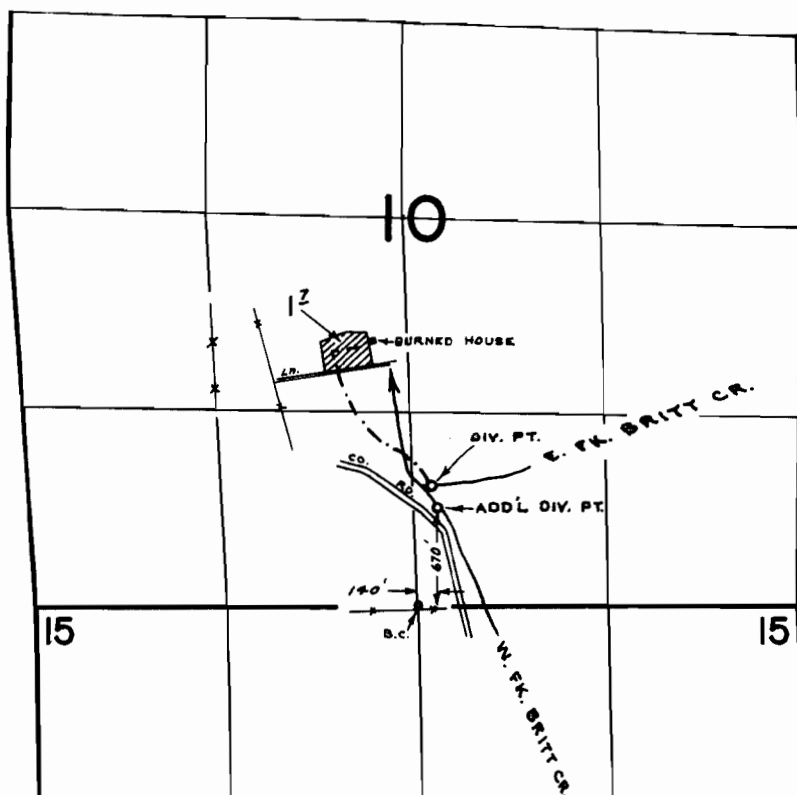

**FINAL PROOF SURVEY**  
UNDER

Transfer No. 3146  
Application No. \_\_\_\_\_ Permit No. \_\_\_\_\_  
IN NAME OF  
**NORMAN GOULD**

Surveyed SEPT. 17, 1975, by R. MUCKEN