


T.36S.,R.4W.,W.M

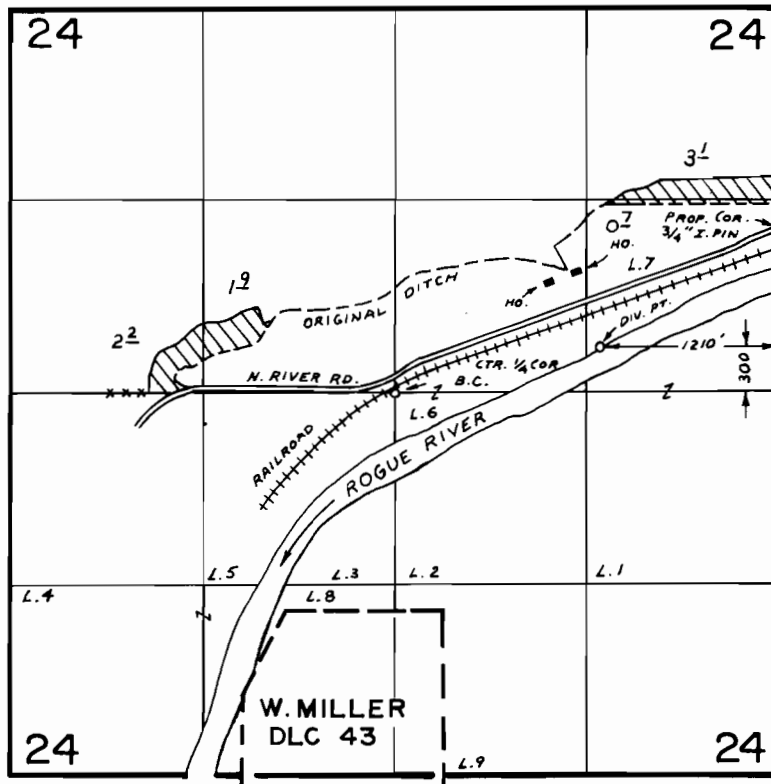

FINAL PROOF SURVEY UNDER

TRANSFER NO. 3148

Application No. Permit No.
IN NAME OF

.....ROBERT D. MURPHY.....

Surveyed JUNE 18, 1980, by B. SUND.....