


Section 5-17-12

SW 1/4

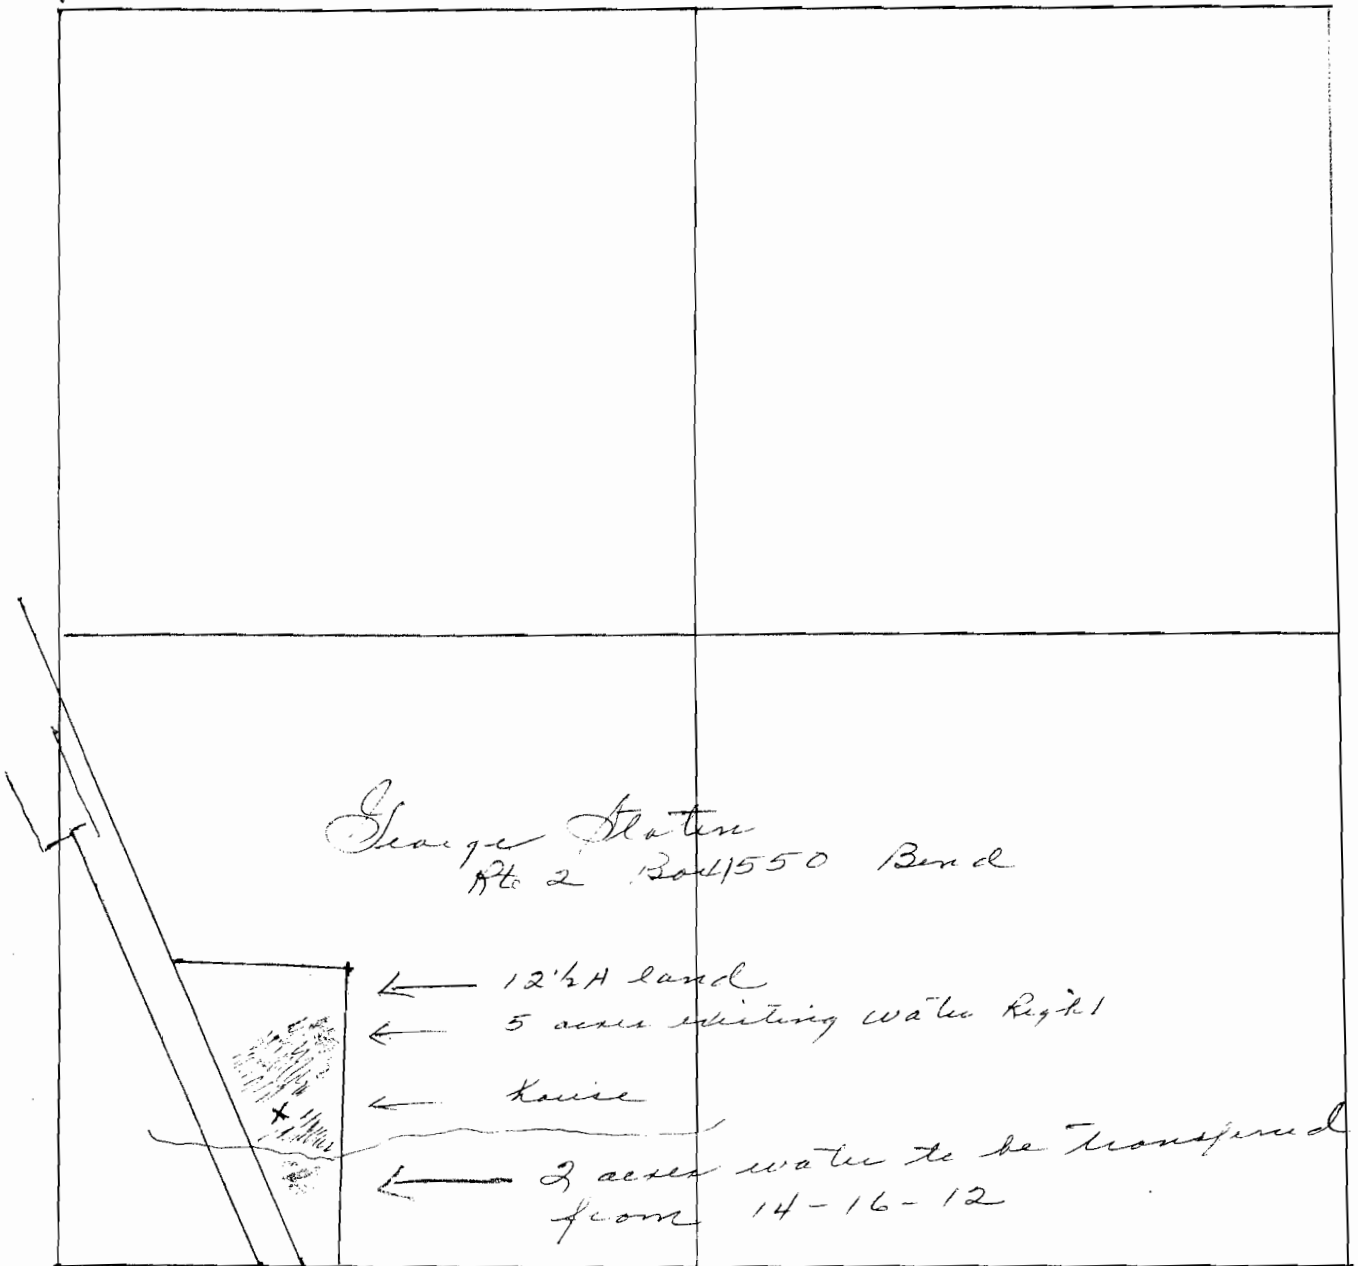

George Statten  
Rte 2 Box 1550 Bend

← 12 1/2 A land

← 5 acres existing water right

← house

← 2 acres water to be transferred  
from 14-16-12

**RECEIVED**

DEC 4 1974

STATE ENGINEER  
SALEM, OREGON