




T. 39 S., R. 11 E., W.M.

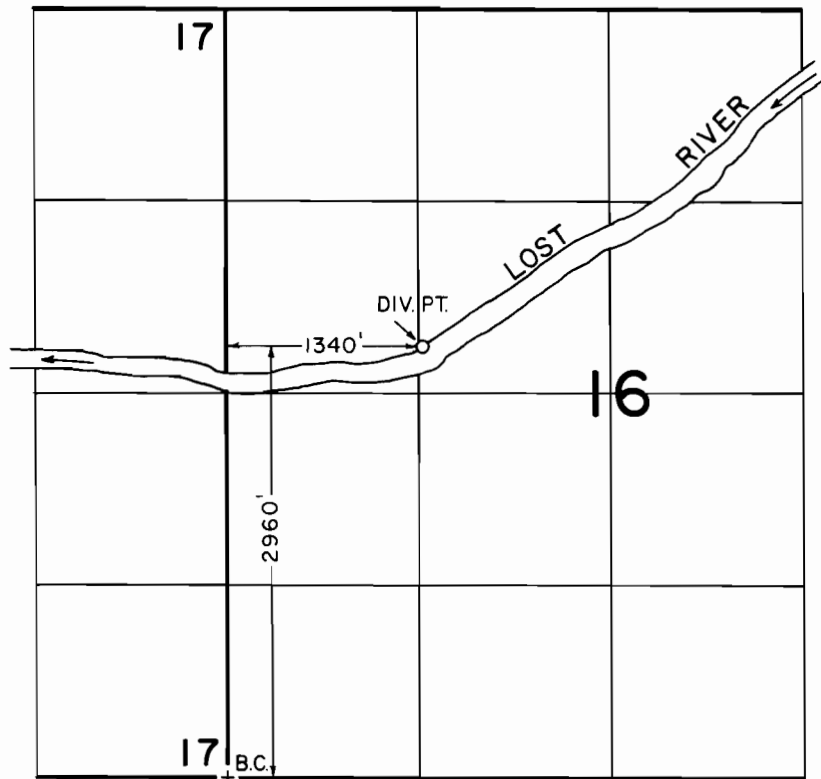

SCALE: 1" = 1320'

**FINAL PROOF SURVEY**  
UNDER

TRANSFER NO. 3163

Application No. .... Permit No. ....  
IN NAME OF

**WALTER CASEBEER**

Surveyed SEPT. 12, 1989, by B. W. BISHOP....