

T. 12 S. R. 21 E. W. M.

RECEIVED
MAR - 8 1976
WATER RESOURCES DEPT.
SALEM, OREGON

RECEIVED


JAN 23 1979

WATER RESOURCES DEPT.
SALEM, OREGON

RECEIVED

MAR 5 1979

WATER RESOURCES DEPT.
SALEM, OREGON

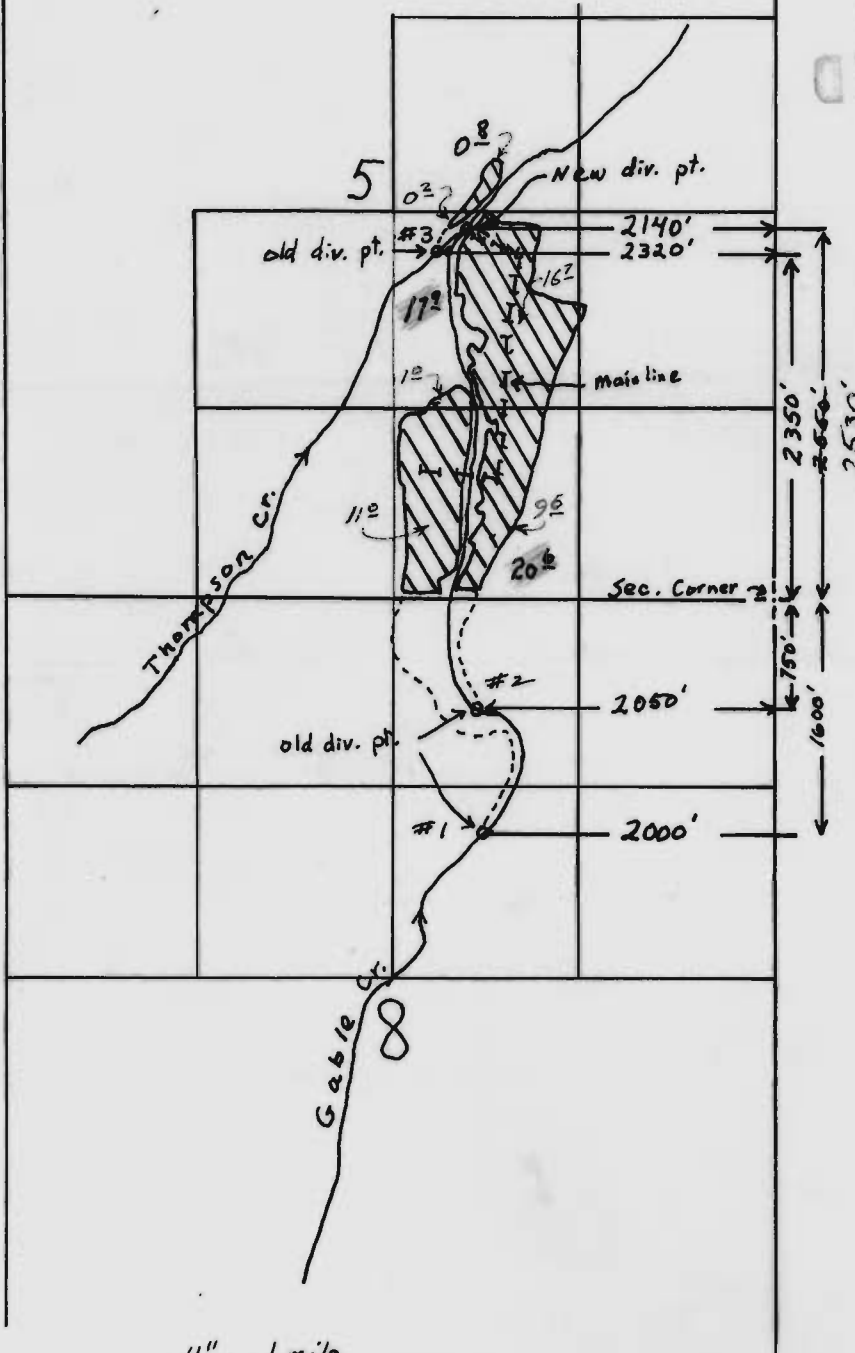

4" = 1 mile

Application for change in point of diversion for
Kenneth Taylor