


T.16S. R.14E. W.M.

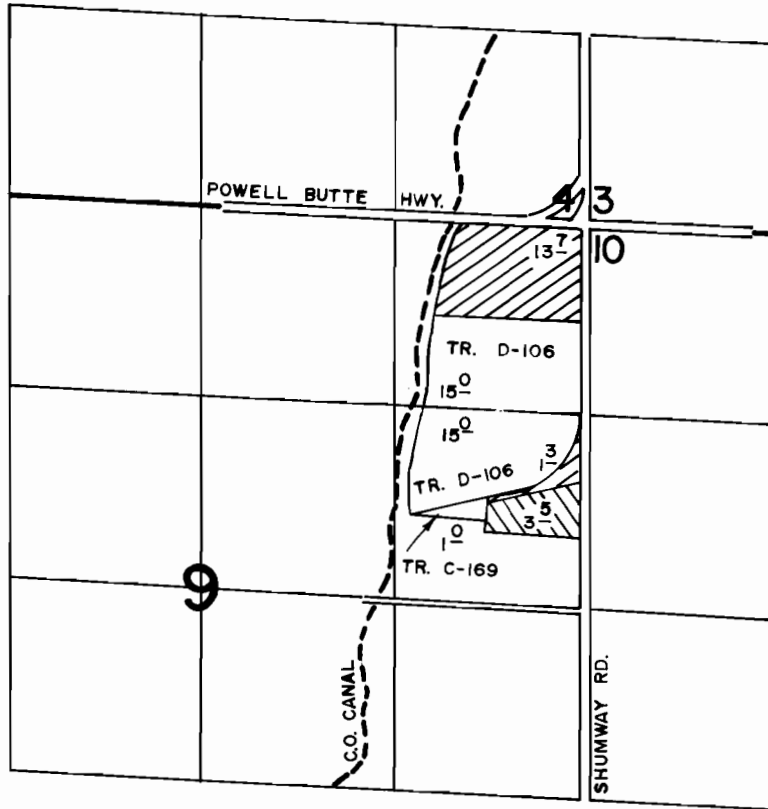

FINAL PROOF SURVEY UNDER

TRANSFER NO. 3174 & 3459
Application No. Permit No.
IN NAME OF

.....**ROBERT W. McCASLAND**.....

Surveyed MAY 27 1980, by L.H. NUNN.....