
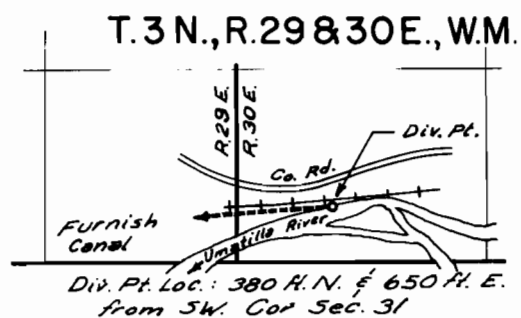


T. 4 N., R. 29 E., W.M.

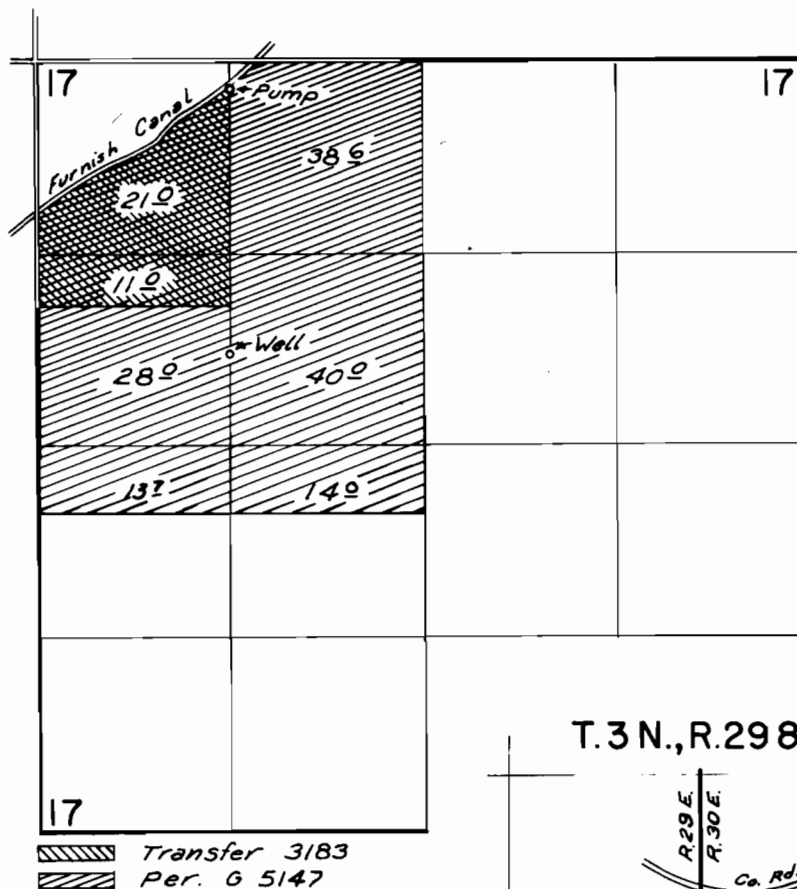

FINAL PROOF SURVEY UNDER

Transfer No. 3183
Application No. G-5386 Permit No. G-5147
IN NAME OF

Maurice Koester

Surveyed July 23, 1976, by L. H. Nunn