


T. 28 S., R. 14 E., W.M.

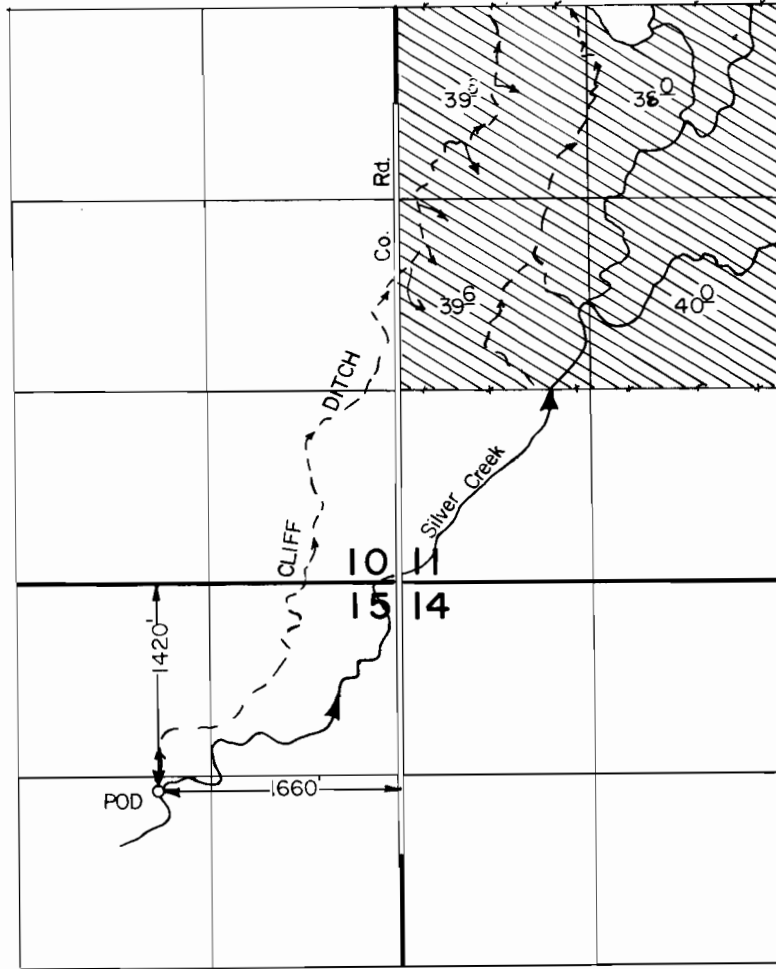

Scale: 1" = 1320'

FINAL PROOF SURVEY UNDER

Transfer 3187

Application No. Permit No.

IN NAME OF

BELL A. LAND & CATTLE COMPANY

Surveyed Sept. 14, 1985, by T. Warren.....