


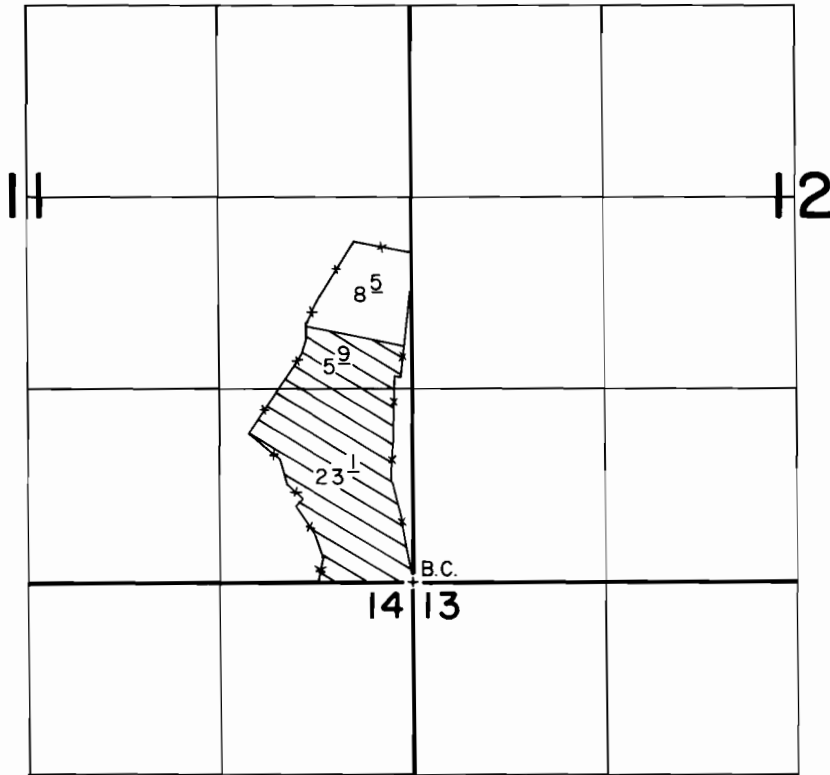

T. 23 S., R. 9 E., W.M.



SCALE: 1" = 1320'

FINAL PROOF SURVEY
UNDER

TRANSFER NO. 3188

Application No. Permit No.

IN NAME OF

DESCHUTES RIVER LAND & CATTLE CO.

Surveyed JULY 6, 1989, by B.W. BISHOP