


# T.5&6S.,R.6W.,W.M.

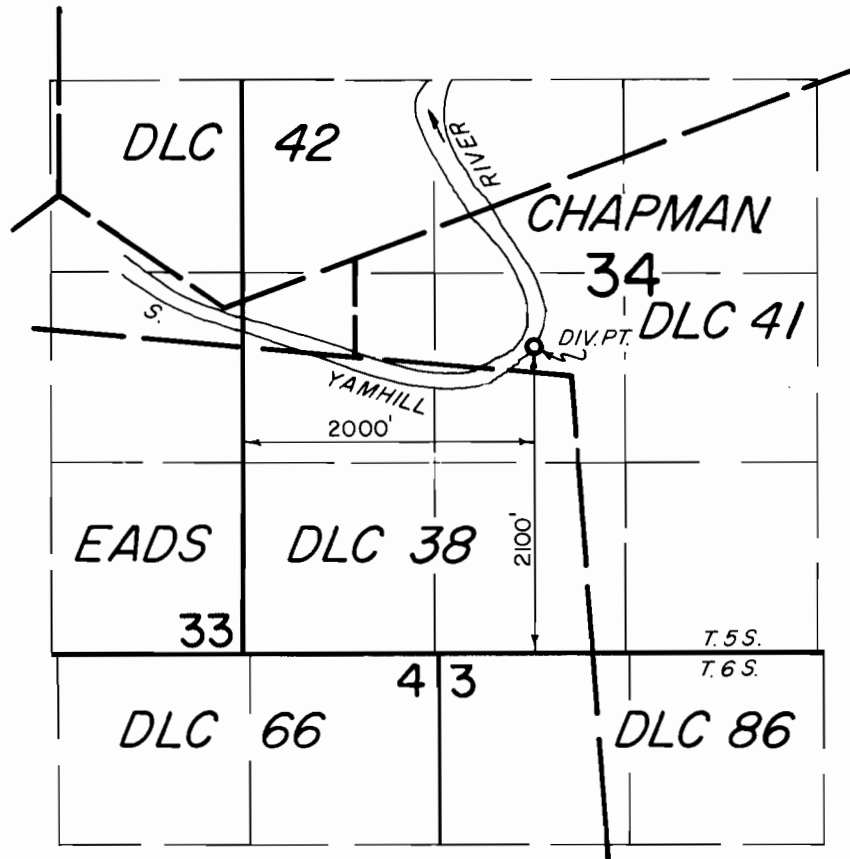

## FINAL PROOF SURVEY UNDER

TRANSFER NO. 3202

IN NAME OF

Robert D. Stevens

Surveyed JUNE 21, 1979, by C. RODRIGUEZ.