


T.5&6S., R.5W., W.M.

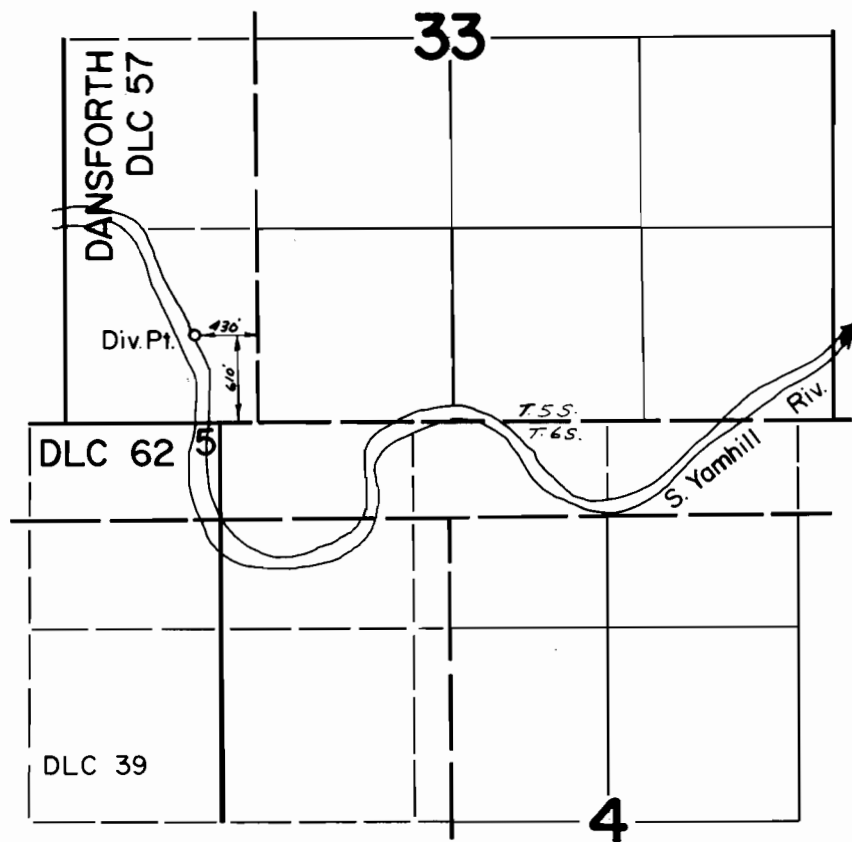

FINAL PROOF SURVEY UNDER

Transfer No. 3208

Application No. _____ Permit No. _____

IN NAME OF

RHODA C. SMITH

Surveyed July 7 1976, by L. H. Nunn