



# T.36 S., R.1 W., W.M.

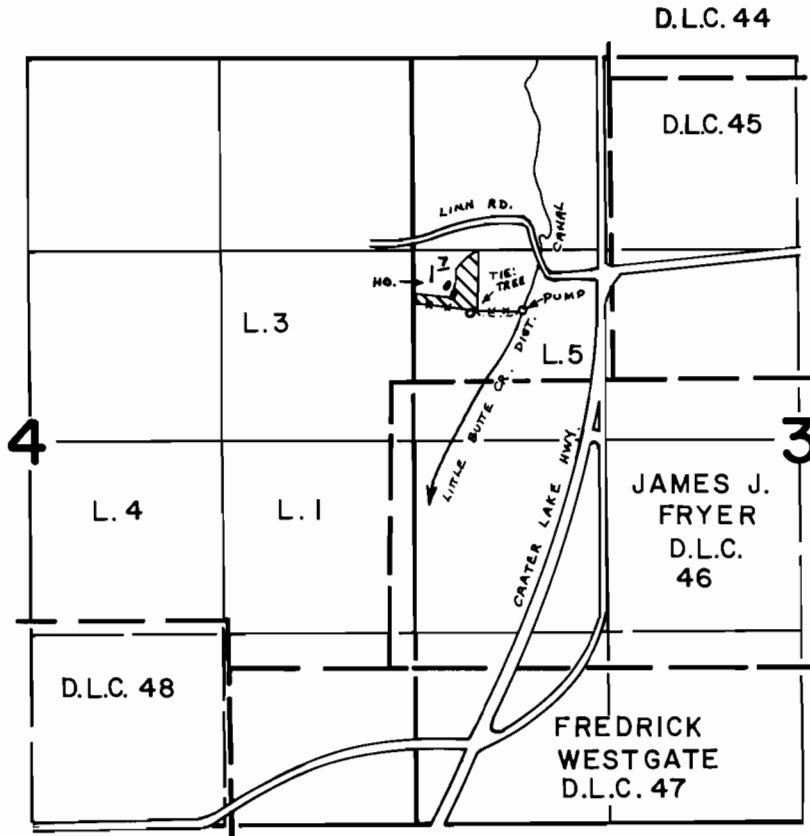

T.35 S., R.1 E., W.M.

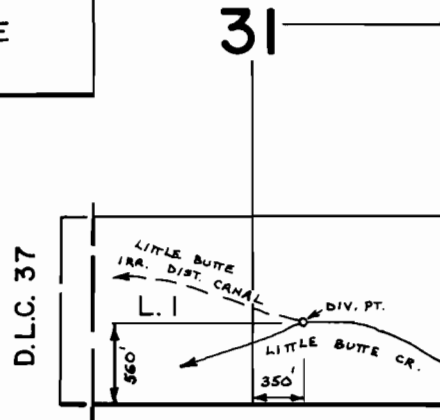

## FINAL PROOF SURVEY UNDER

Transfer No. 3210

Application No. \_\_\_\_\_ Permit No. \_\_\_\_\_  
IN NAME OF

DONALD R. & LETA M. BAKER

Surveyed AUG. 24 1978 by B. SUND

D.H.M.  
P.T.S.-1978-14-C  
& BAX-3AA-6