


T.35S.,R.4W.,W.M.

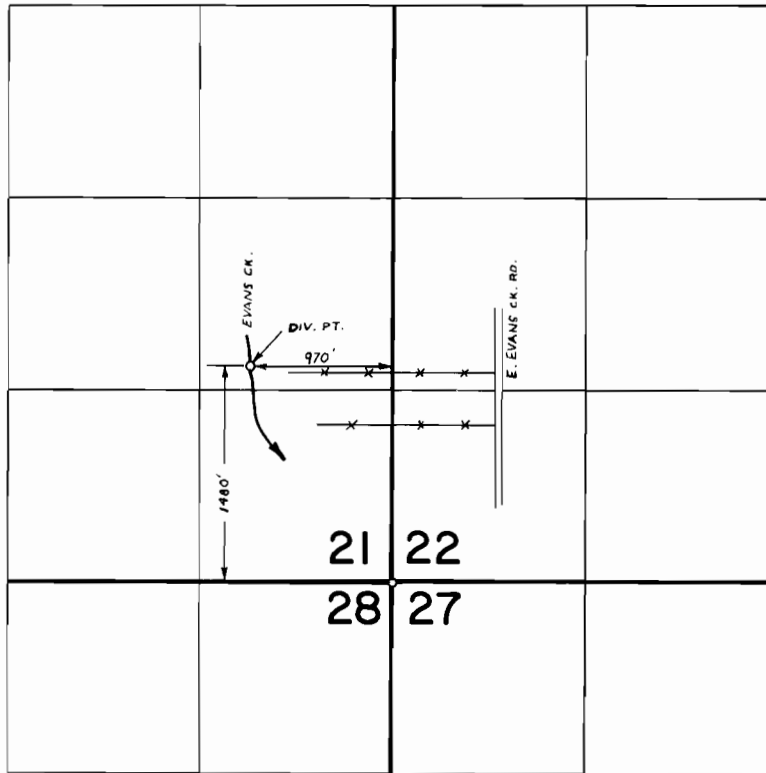

FINAL PROOF SURVEY UNDER

TR-3211

Application No. Permit No.

IN NAME OF

JAMES R. & MYRNA L. KEITH

Surveyed APR. 11 1978, by B. SUND