


T.35 S., R.4 W., W.M.

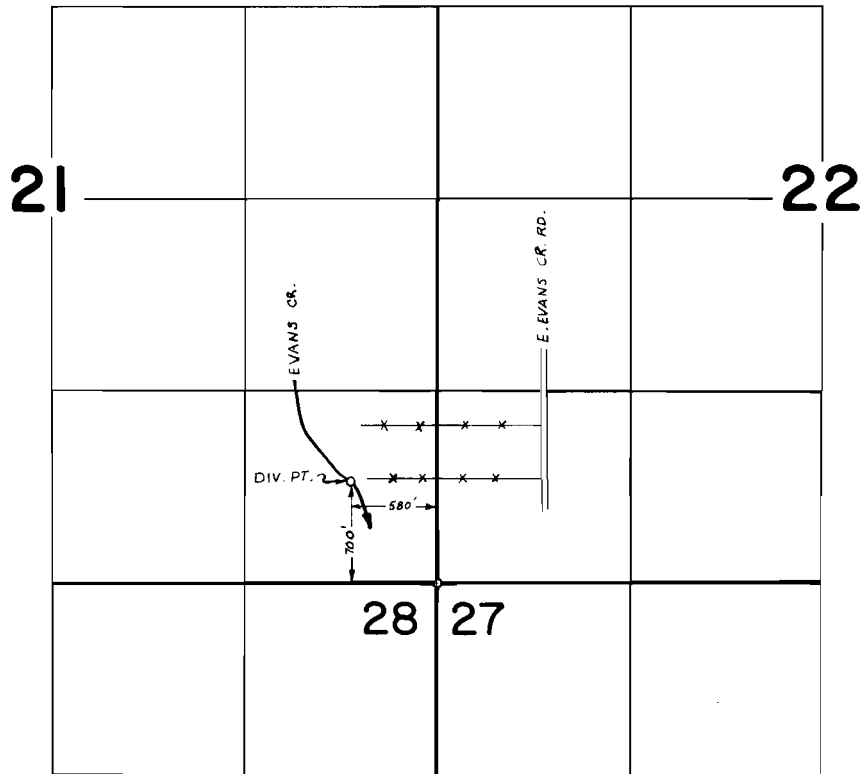

**FINAL PROOF SURVEY**  
UNDER

Application No. TR-3215 Permit No. ....  
IN NAME OF

DAN R. KEWISH

Surveyed APR. 11 1978, by B. SUND