


T.12S.,R.1W.,W.M.

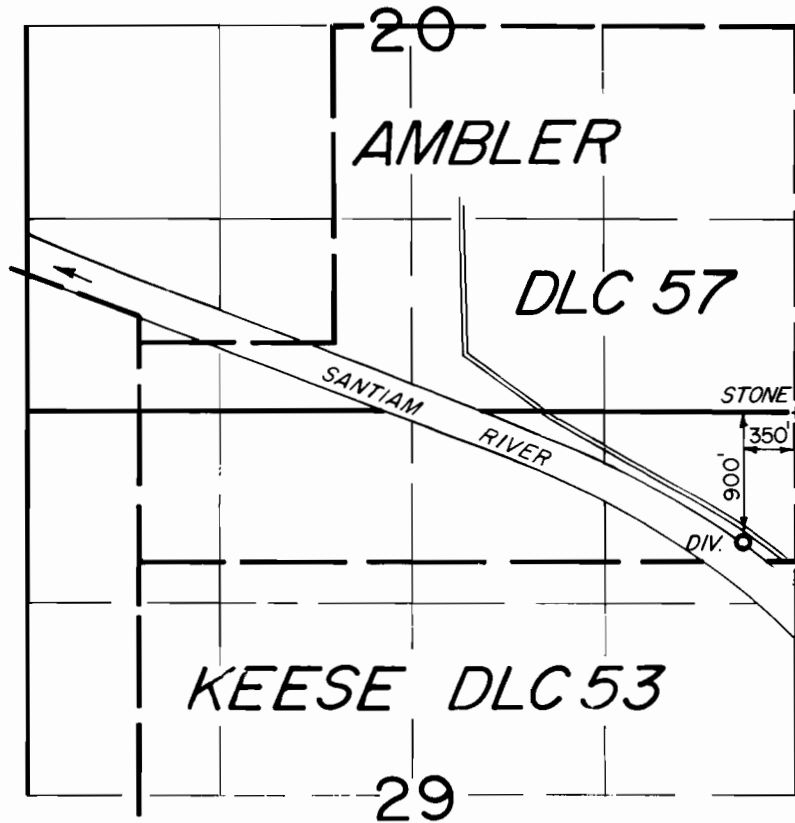

FINAL PROOF SURVEY
UNDER

TRANSFER NO. 3216

IN NAME OF

Charles E. & Lucille H. Higgins

Surveyed MAY 3, 1979, by J. Brown