


T.6S.,R.6W.,W.M.

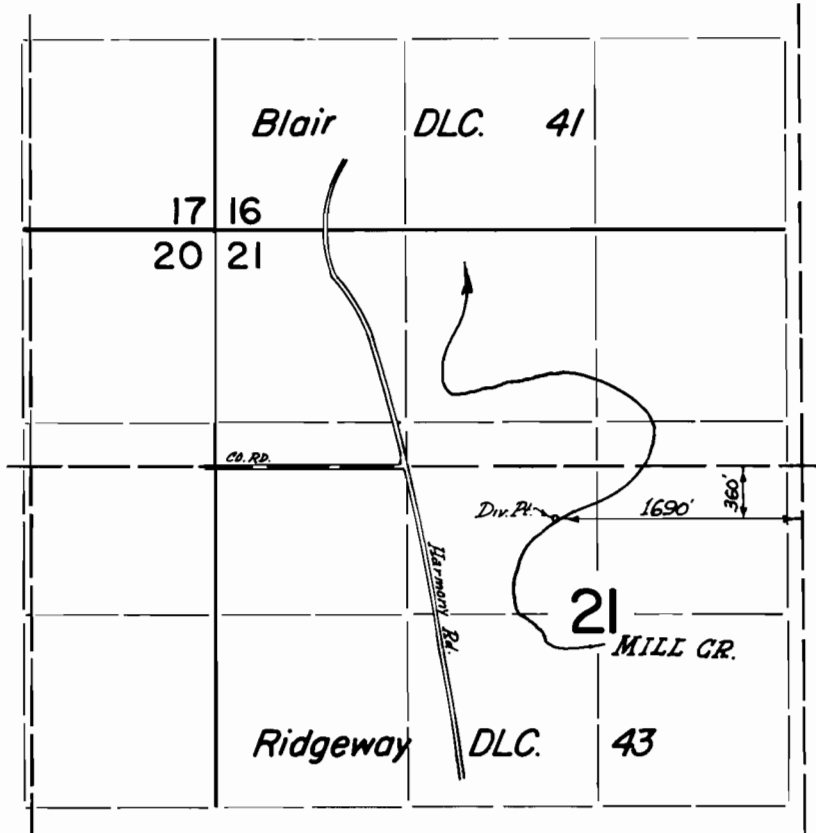

FINAL PROOF SURVEY

UNDER

Transfer Nos. 3217, 3218, 3219, & 3220

Application No. _____ Permit No. _____

IN NAME OF


GEORGE J. & HERTA L. RIGGS

Surveyed Aug 8..... 1977.. by L.M. Tonn.....

T.6S.R.6W. WM

RECEIVED
MAY 5 1975

STATE ENGINEER
SALEM, OREGON

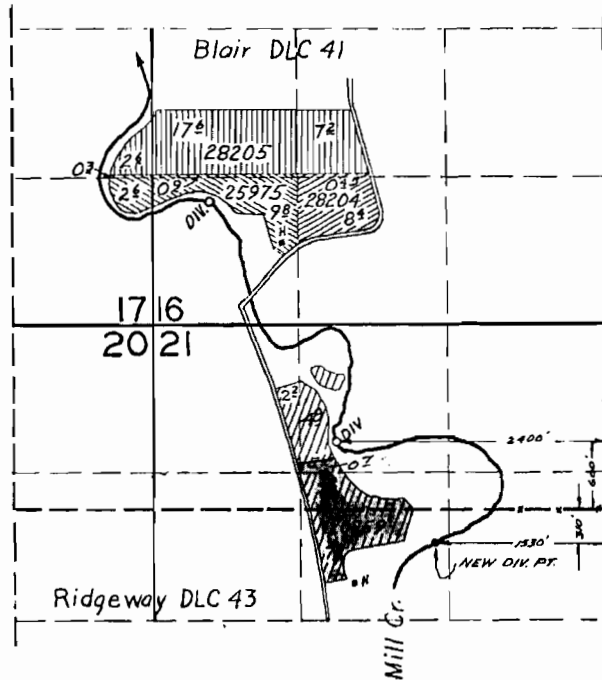

TRANSFER APPLICATION FOR CHANGE IN PT. & DIV.
FOR 12.7 ACRES FOR GEORGE & HERTA RIGGS

FINAL PROOF SURVEY

20959 161.06
20205 22193
28204 22192
Application No. 25975 Permit No. 20357...
Gerald R. Allen
Otto Debrick
Dan O. Blair
Dan O. Blair

Surveyed July 12, 1954, by T. Jones

T-3218

DFP-3D-68

T-3218

